


JUL 6 1948  
14616

FILED  
GREENVILLE CO. S. O.

JUL 6 12 00 PM 1948

OLLIE FARNSWORTH  
R.M.C.

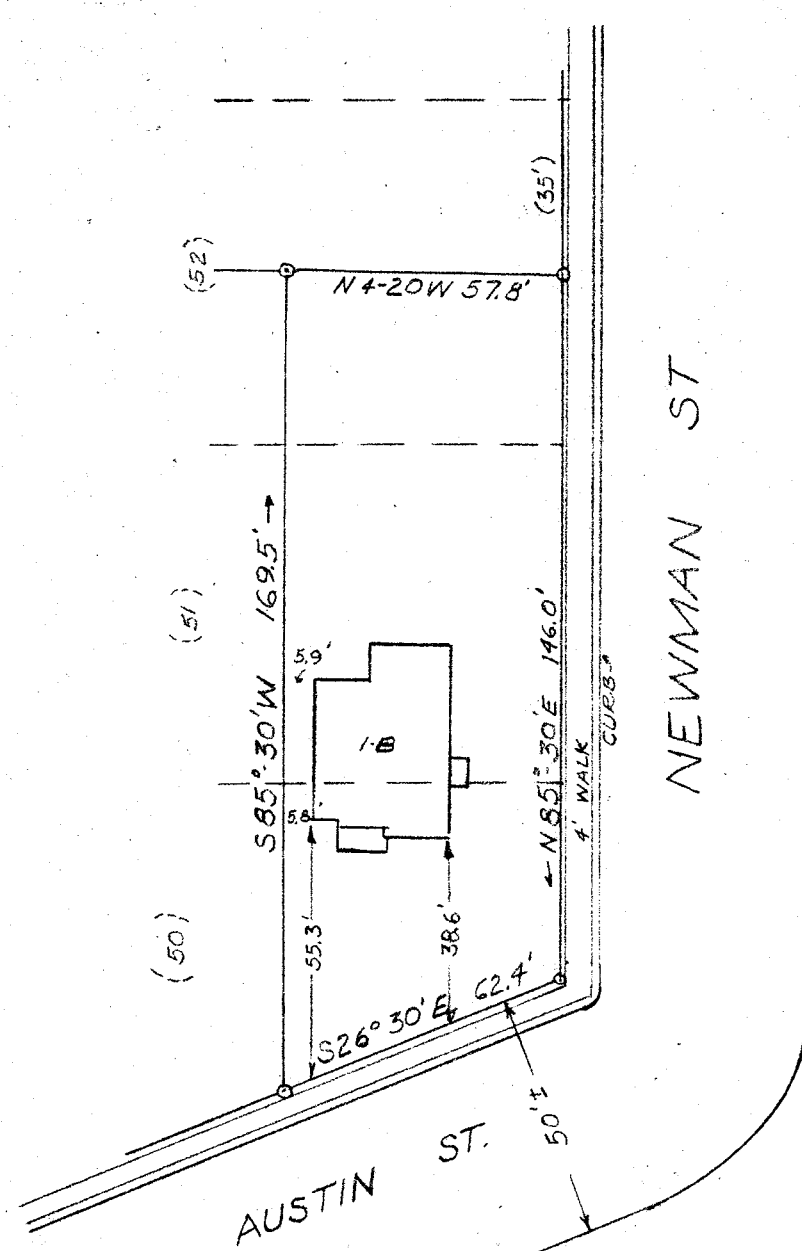

PROPERTY OF  
**WILLIAM M. & JANE G. CLARK**

SCALE: 1/4" = 40 FT. GREENVILLE, S.C. 1 JULY 1948

This is to certify that on the 1st day of July, 1948, I surveyed part of lots 50, 51, & 52 of the McDaniel Heights Subdivision filed in Plat Book "L", pages 46 & 47, and that the property lines, walls and buildings are as shown hereon; that the buildings located on said property do not encroach or project on adjacent streets or property; and that no adjacent buildings or walls encroach or project on said premises.

*Ollie Farnsworth*  
Registered Engineer #808

PIEDMONT ENGINEERING SERVICE  
GREENVILLE S.C.

B9P40

#14616 Paid This 6 day of July 48  
and returned to Col. H. L. 750 M.  
*Ollie Farnsworth*  
Register Meas. Conveyance Greenville County, S.C.