Plat Book G Page 177

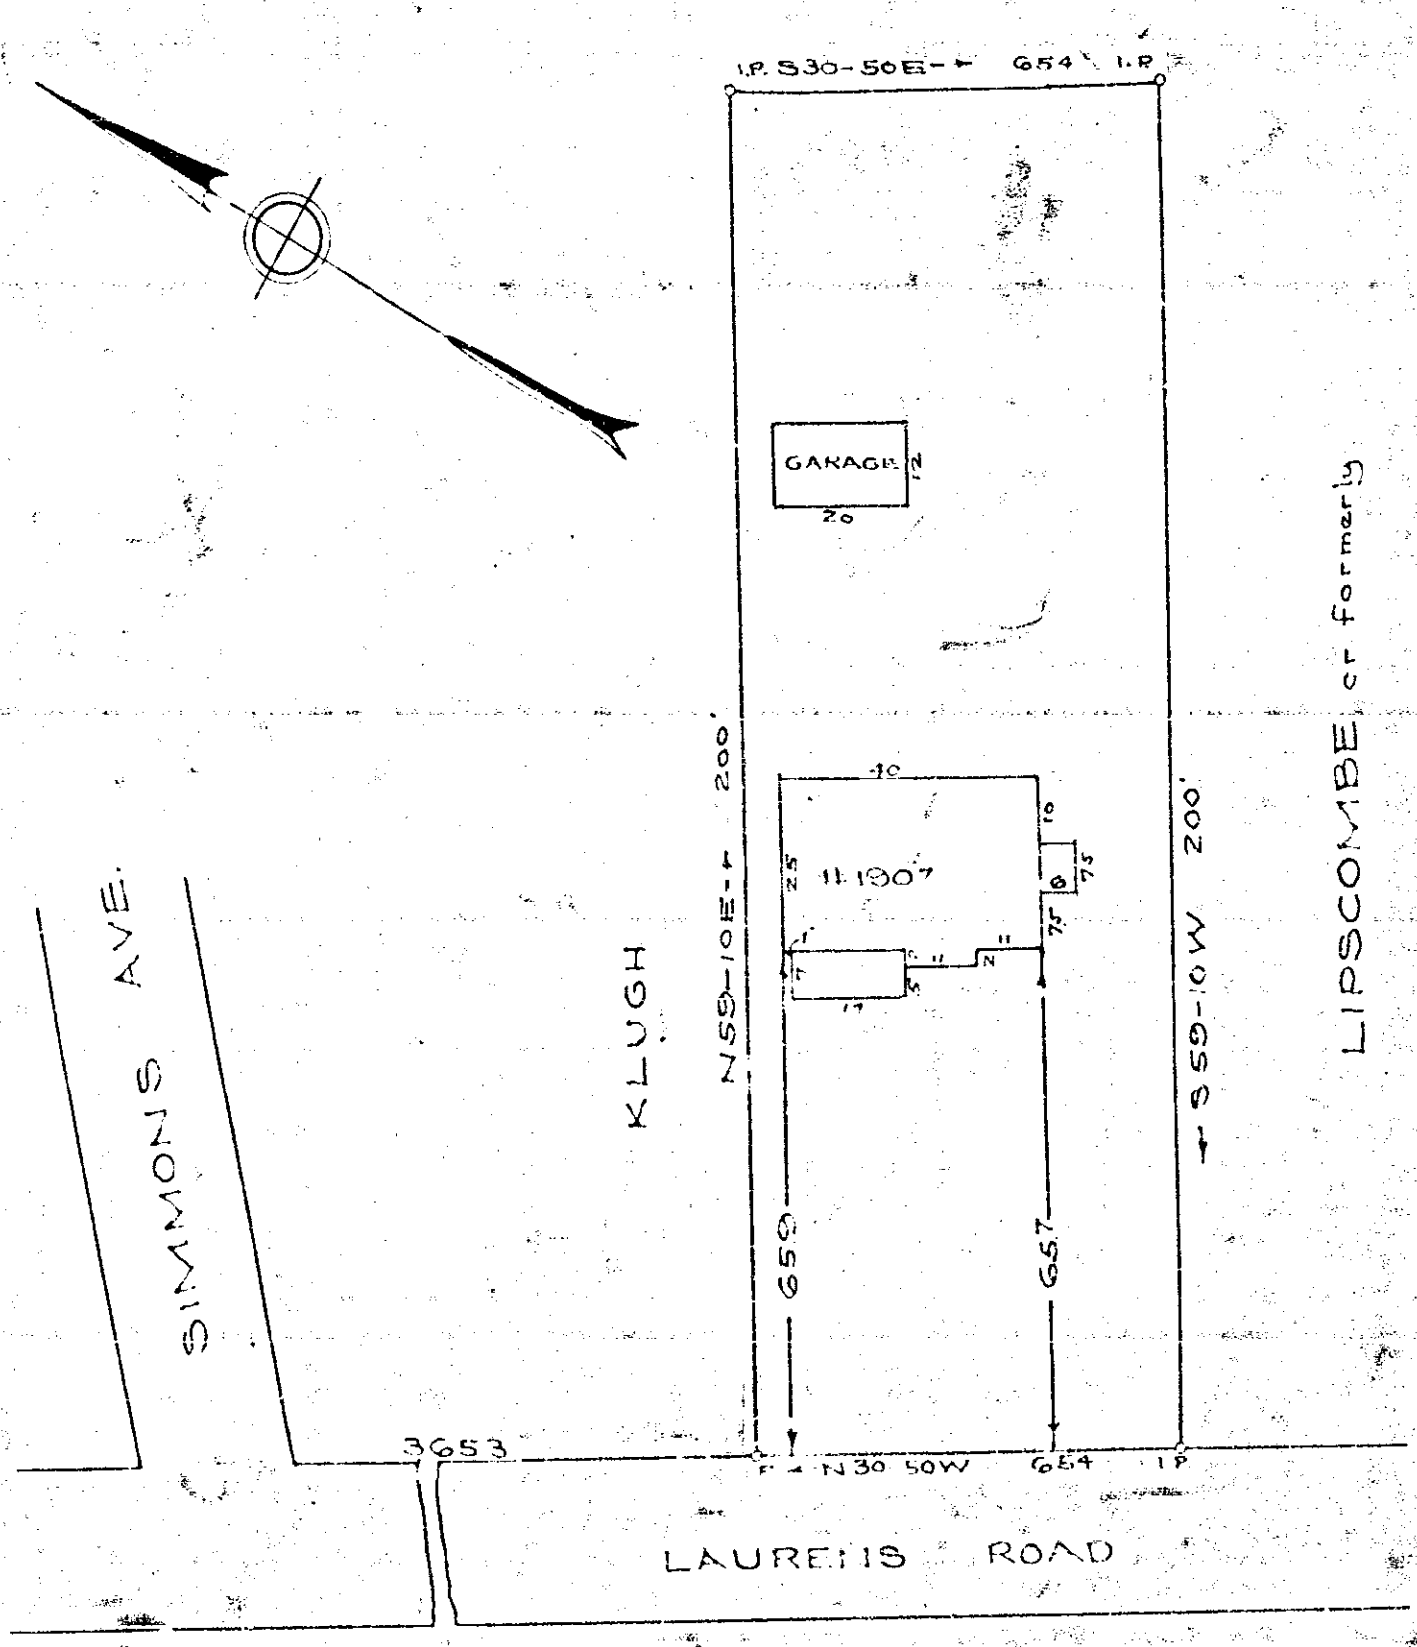

PROPERTY OF
GEORGE A. ROBINSON
NEAR GREENVILLE S. C.
Scale 1"=30' Sept 1948

21138

SEP 21 1948

This is to certify that on the 24th day of September, 1948, I surveyed the property shown on this plat; which is taken from an unplated portion of the property shown on the plat of East Lynn Addition, filled in Plat Book H page 220, and that the property lines, wells and buildings are as shown hereon; that the buildings located on said lot do not encroach or project on adjacent streets or property; and that no adjacent buildings or wells encroach or project on said premises.

R. E. Walton
Registered Engineer.

Plat Filed This 24 day of Sept 1948
and Recorded in Vol. h Page 177 at 12:14 M.
Ollie Farnsworth
Register Mesne Conveyance Greenville County, S. C.
21138

231