


FILED
 GREENVILLE CO. S.C.
 OCT 14 2 13 PM 1948
 OLLIE FARNSWORTH
 R.M.C.

22594
 OCT 14 1948
 Filed This 14 day of Oct. 1948
 And Recorded in Vol. 187 at 2:13 P.M.
 Ollie Farnsworth #22594
 Register in the Office of the Register of Deeds, Greenville County, S.C.

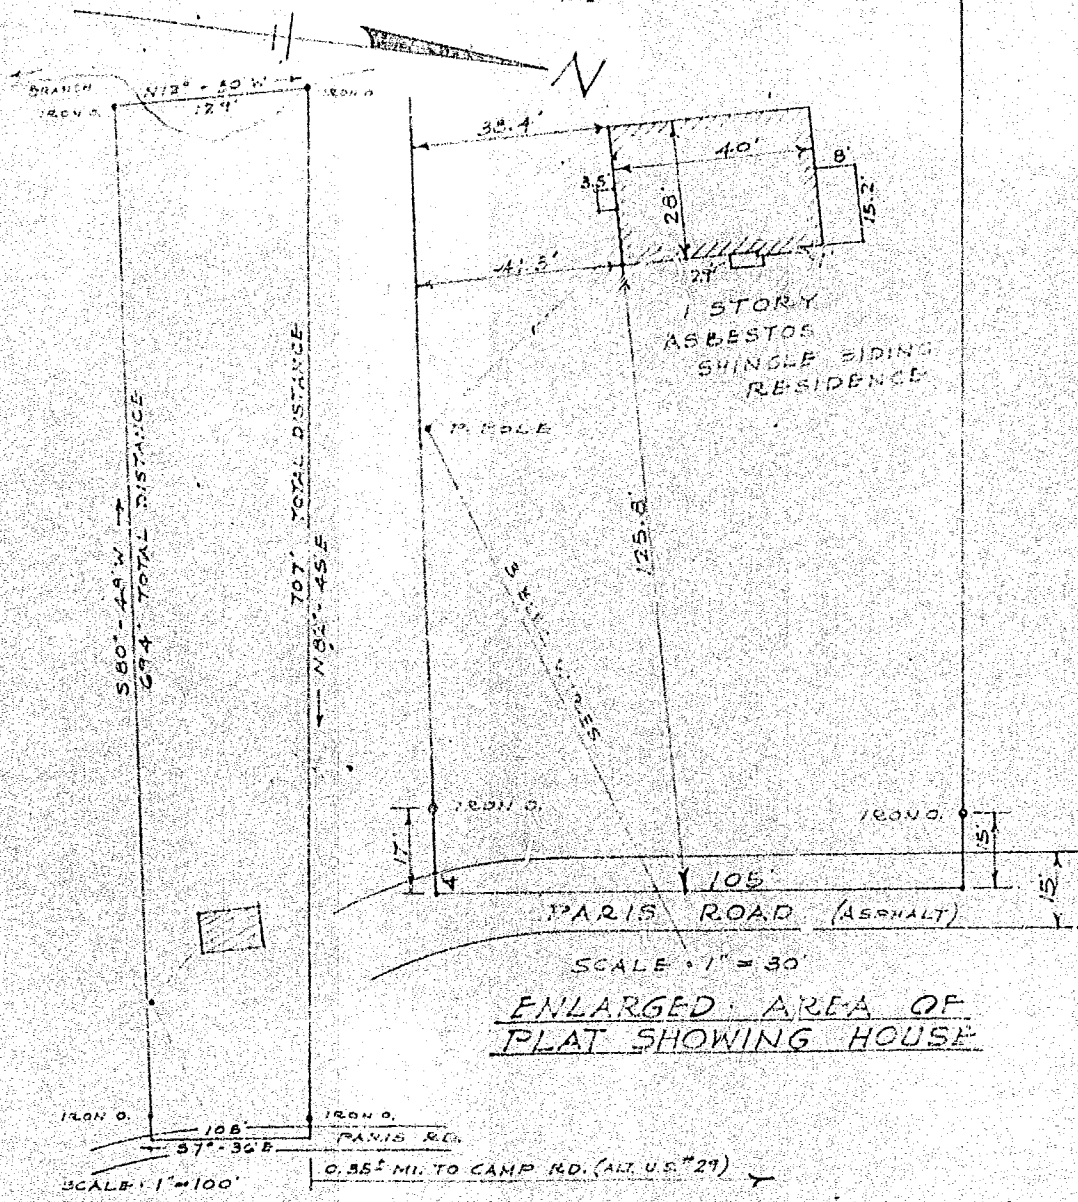

PROPERTY OF: _____
JENNIE VAUGHN & MILDERVA VAUGHN
 LOCATED IN "GREENVILLE COUNTY" NEAR THE
 CITY OF GREENVILLE • S.C.
 PICKELL & PICKELL • ENGINEERS
 GREENVILLE • SOUTH CAROLINA
 SCALE: AS SHOWN DATED: SEPT. 15, 1948

I HEREBY CERTIFY THAT THE MEASUREMENTS AS SHOWN ON THIS PLAT ARE CORRECT AND THERE ARE NO PROJECTIONS OR ENCROACHMENTS OTHER THAN SHOWN.

U. 187

Raymond M. Pickell REG. ENGR.

DAD COPY

187