MAY 2 1949

10103

FILED
GREENVILLE CO. S. C.

MAY 2 10 52 AM

OLLIE FARNSWORTH
R.M.C

PROPERTY · OF ·
MRS · V · C · W · HAHN · ESTATE ·

AUSTIN · TOWNSHIP · GREENVILLE · COUNTY ·

SOUTH · CAROLINA ·

SCALE: 1" = 500 · FEET · APRIL · 8 · 1937 ·

SURVEYED MARCH · 26 · 1937

H · S. BROCKMAN, SURVEYOR,
GREER, S.C ·

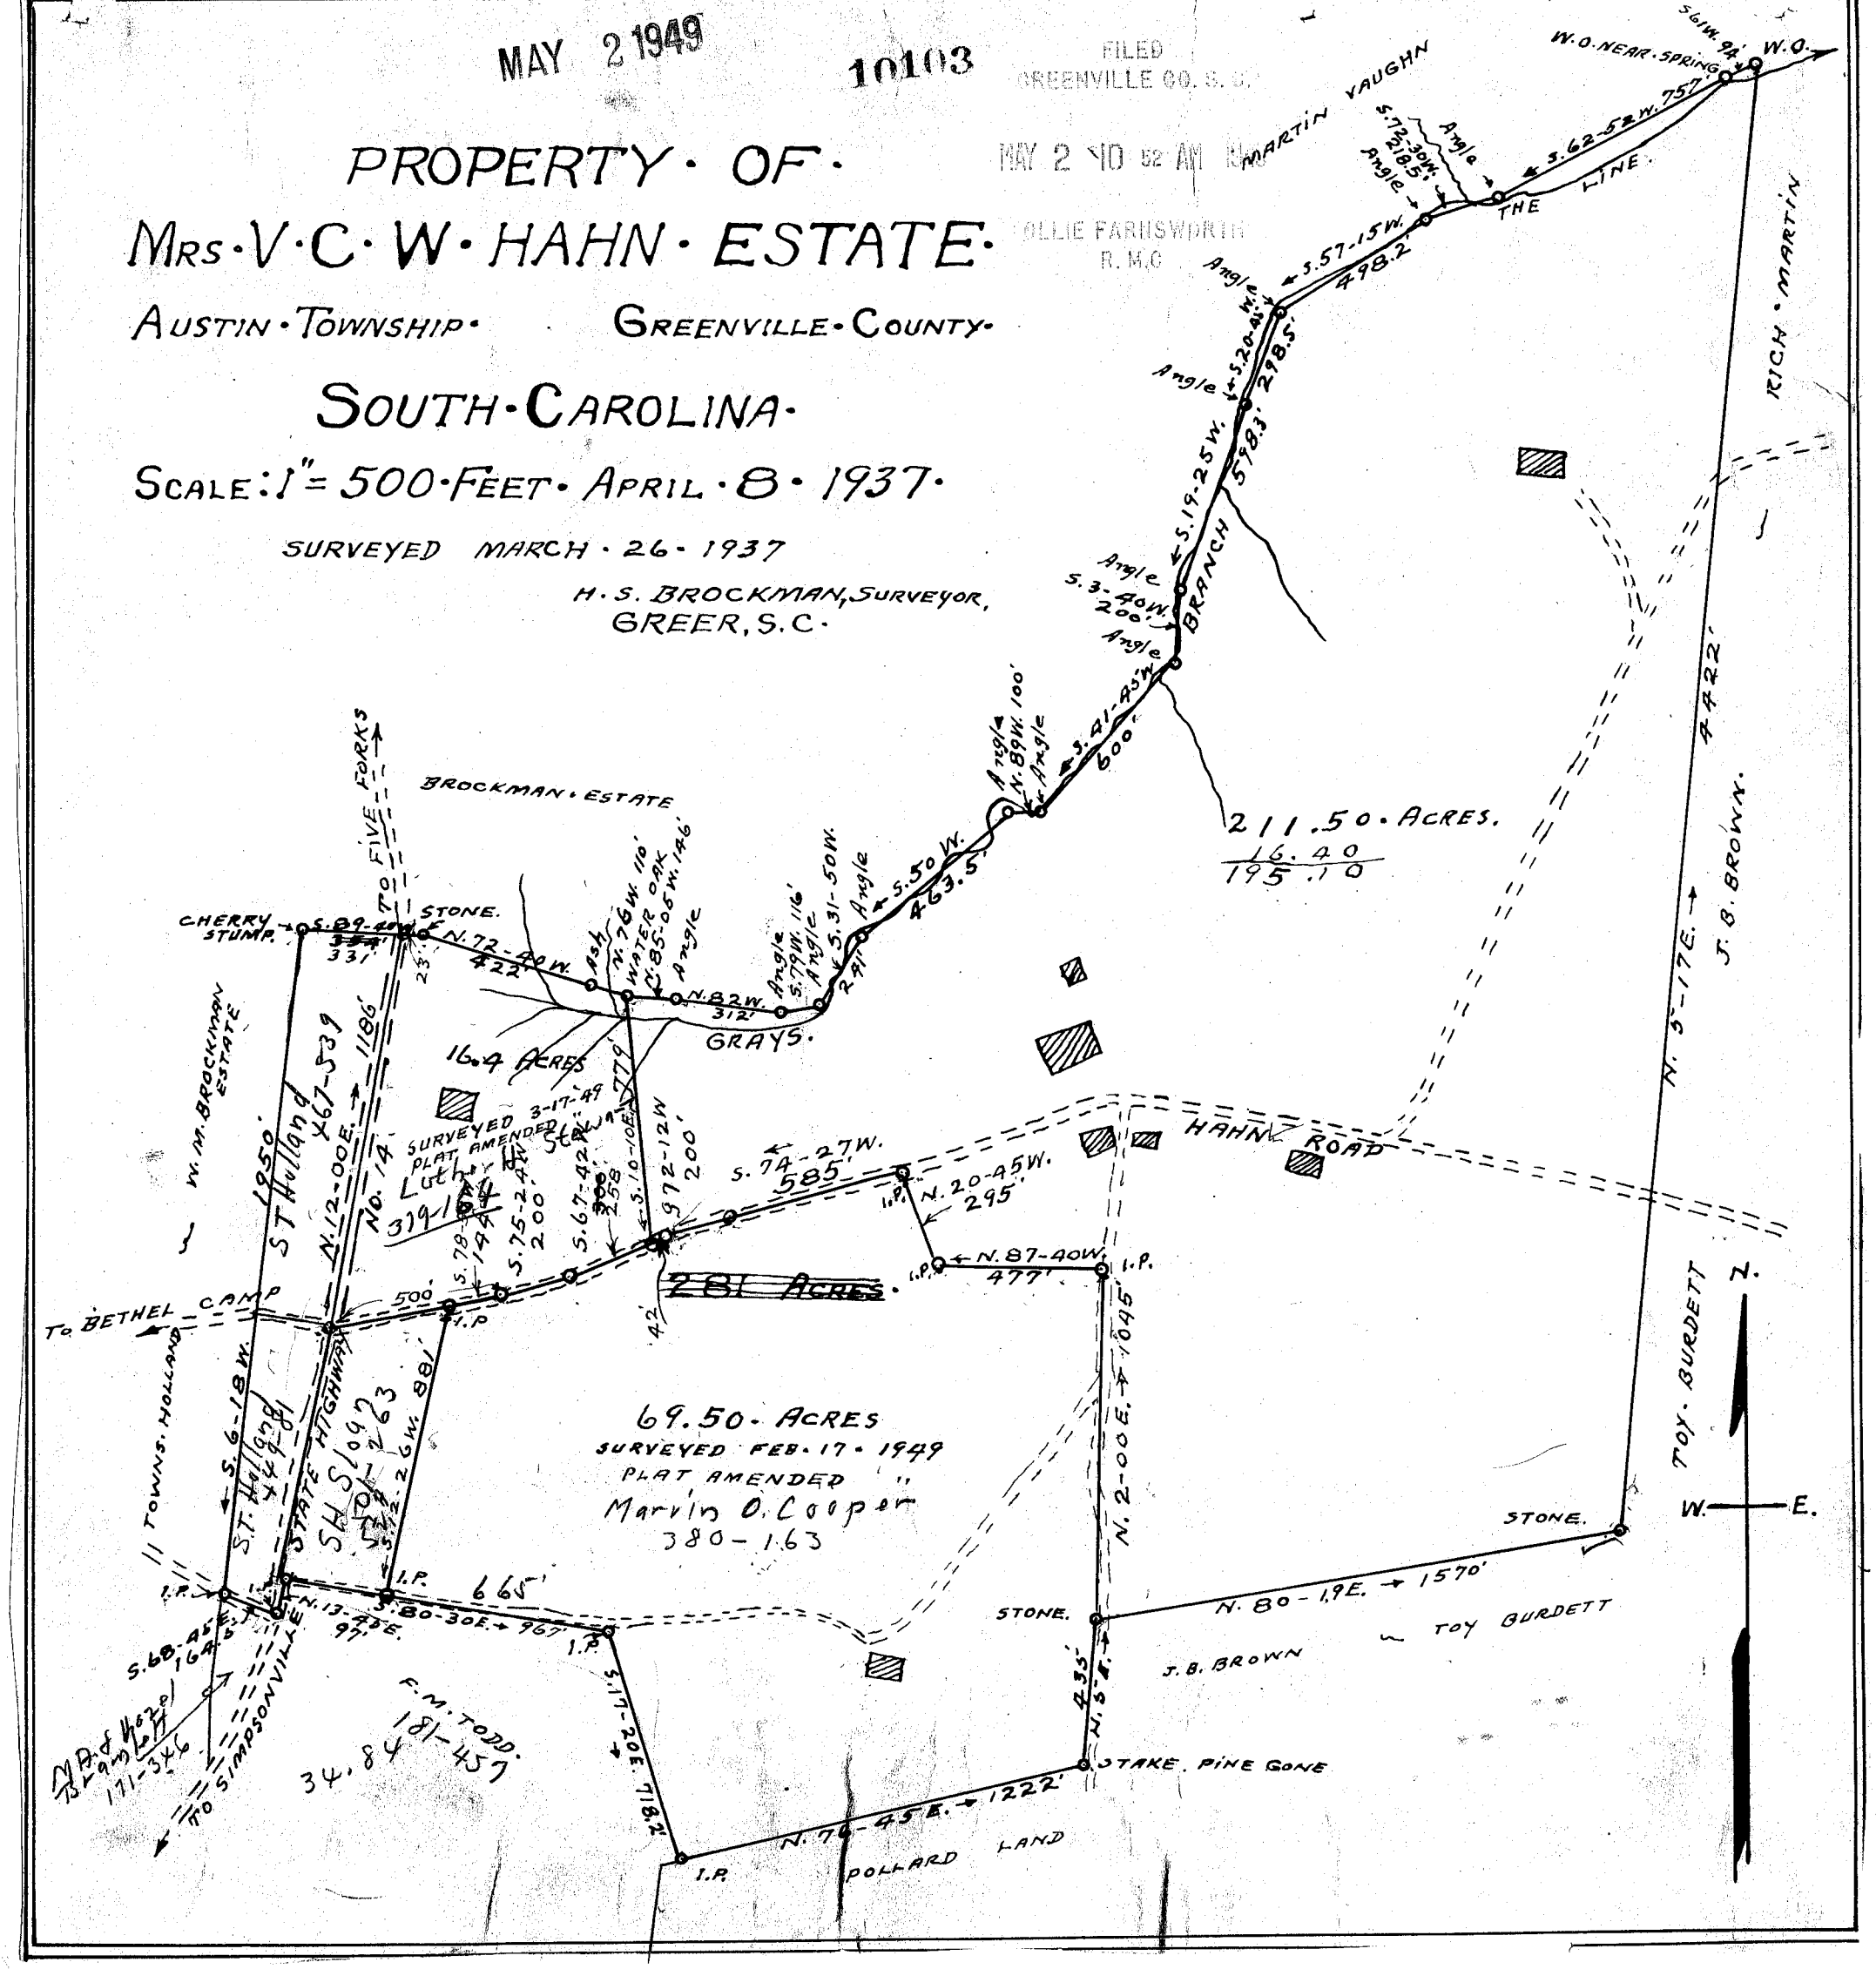

Original Dwg 281 A
Dwg 1029
178.1

6.44
200
278
11.02

10103 Filed This 2 day of May 19 49
And Recorded in Vol. 7 Page 155 at M.
Ollie Farnsworth
Register Mesne Conveyance Greenville County, S. C.