


50 GALLIVAN AVENUE

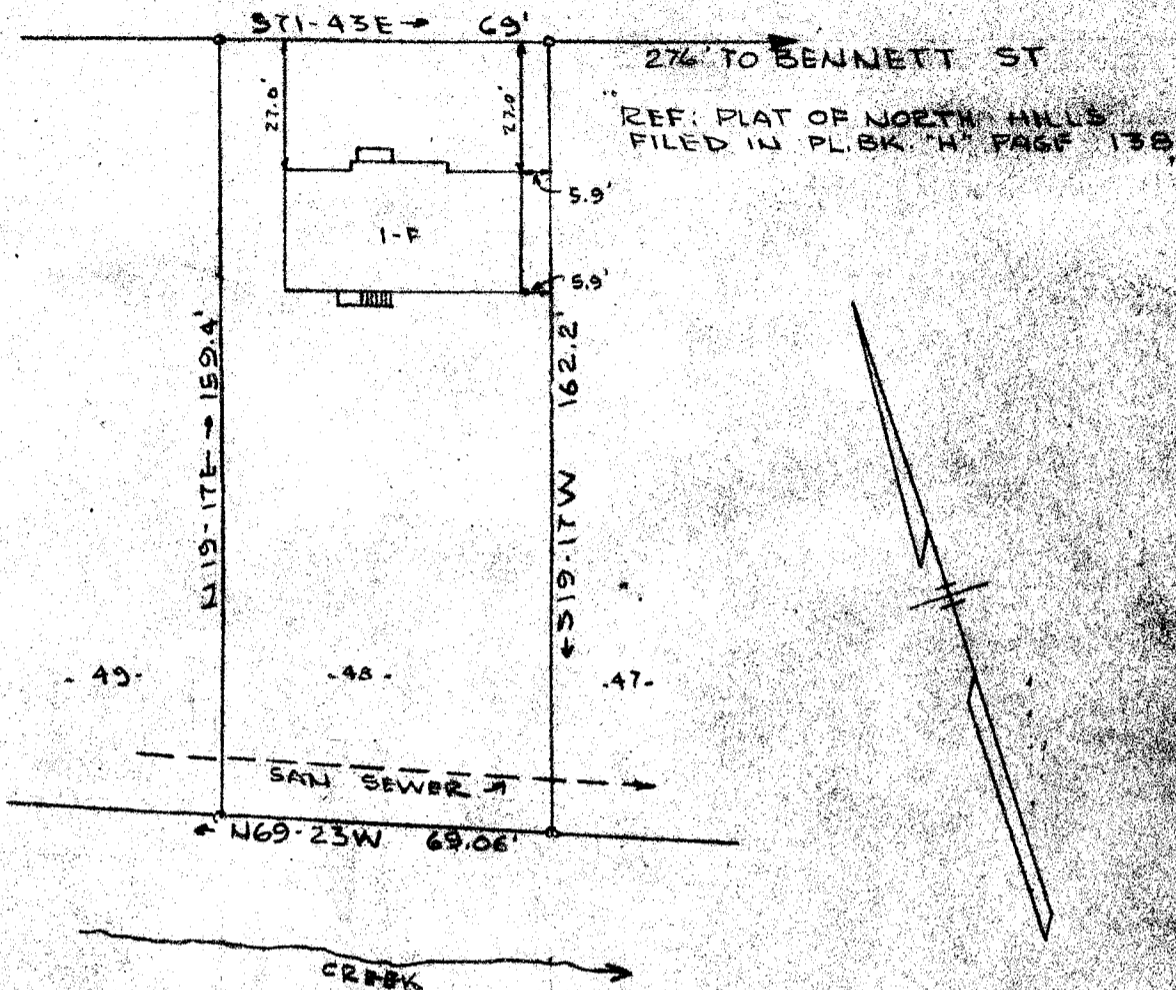

PROPERTY OF JOHN P. DIERCKS GREENVILLE SC.

SCALE 1" = 40 FT 28 JAN 1950

This is to certify that on the 28th day of January 1950, I surveyed lot 48, Plat of North Hills, filed in Plat Book "H", page 138; and that the property lines, walls and buildings are as shown hereon; that the buildings located on said property do not encroach or project on adjacent streets or property; and that no adjacent buildings or walls encroach or project on said premises.

500



7-87

3114

Registered Engineer #808

FEB 6 1950

PIEDMONT ENGINEERING SERVICE GREENVILLE, S. C.

B34P46

*Handwritten signature/initials*

#3114 FILED This 6 Day of Feb. 10 1950

And Recorded in Vol. 7 Page 87 at 2:33 P.M.

Gladia Farnsworth Register Mesne Conveyance Greenville County, S. C.

87