AUG 28 1950
20881

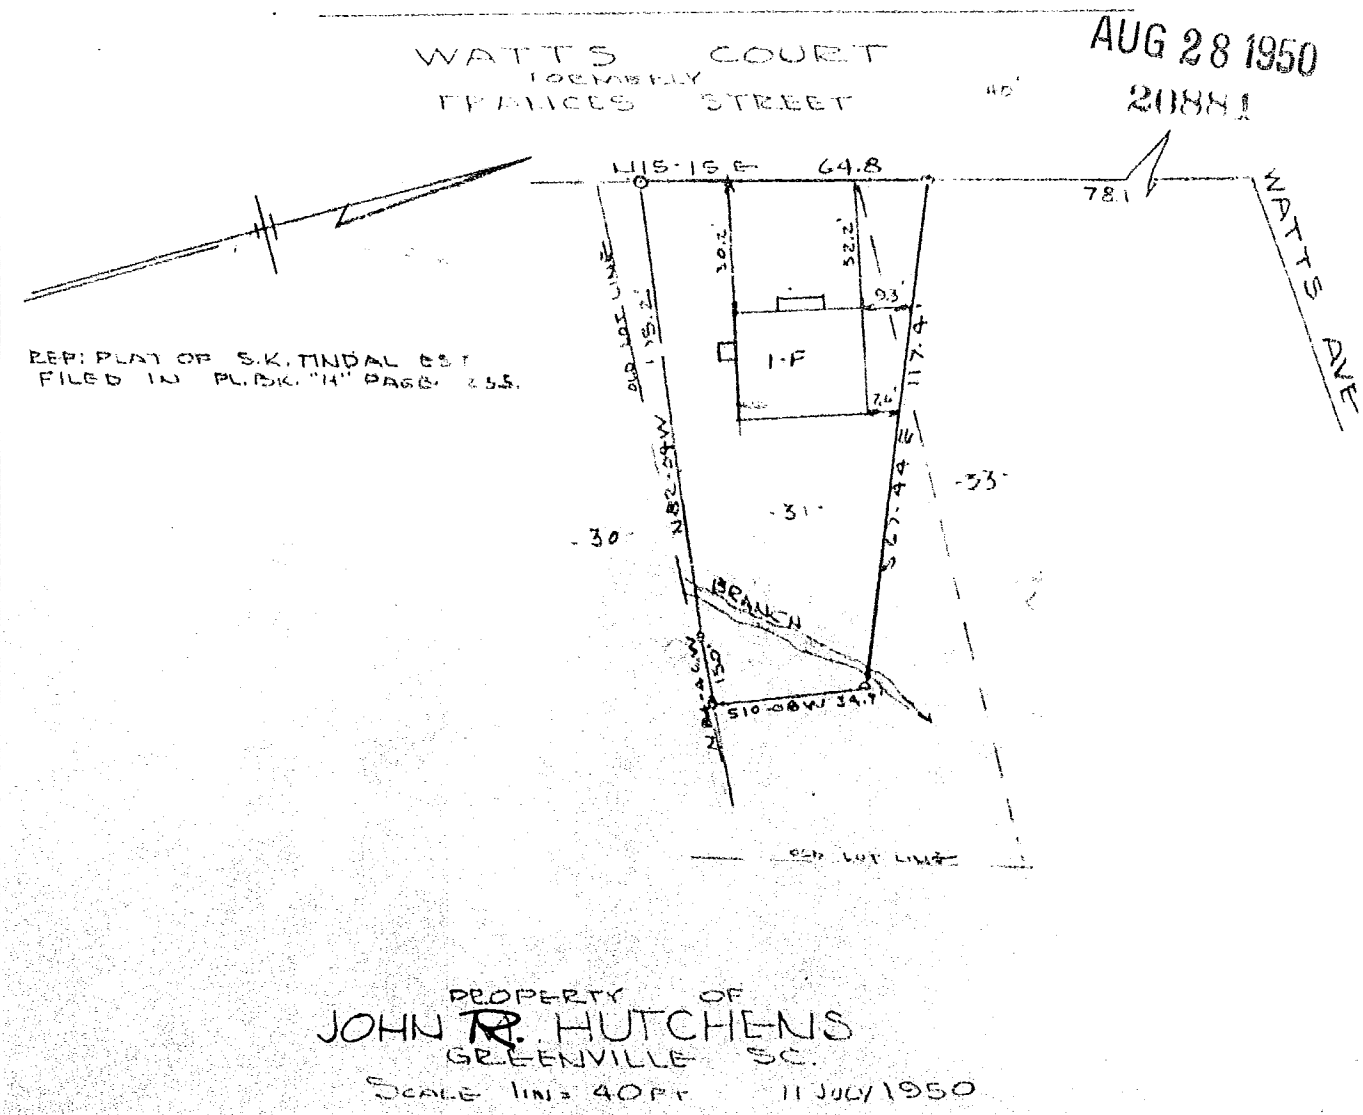

PROPERTY OF
JOHN R. HUTCHENS
GREENVILLE S.C.
SCALE 1IN = 40FT 11 JULY 1950

This is to certify that on the 11th day of July, 1950, I surveyed a portion of lots 33 & 31, plat of S. K. Tindal Estate, filed in Plat Book H at page 235; and that the property lines, walls and buildings are as shown hereon; that the buildings located on said property do not encroach or project on adjacent streets or property; and that no adjacent buildings or walls encroach or project on said premises.

Registered Engineer #808

"Z" - 5

PIEDMONT ENGINEERING SERVICE
GREENVILLE, S. C.

B40P26

1035

#20881 Filed This 28 day of Aug. 1950
And Recorded in Vol. Z Page 5 at V M.
Register Mesne Conveyance Greenville County, S. C.

BAD COPY