


FILED
GREENVILLE CO. S. C.

DEC 5 12 10 PM 1950

OLLIE FARNSWORTH
R. M. O.

29311

DEC 5 1950

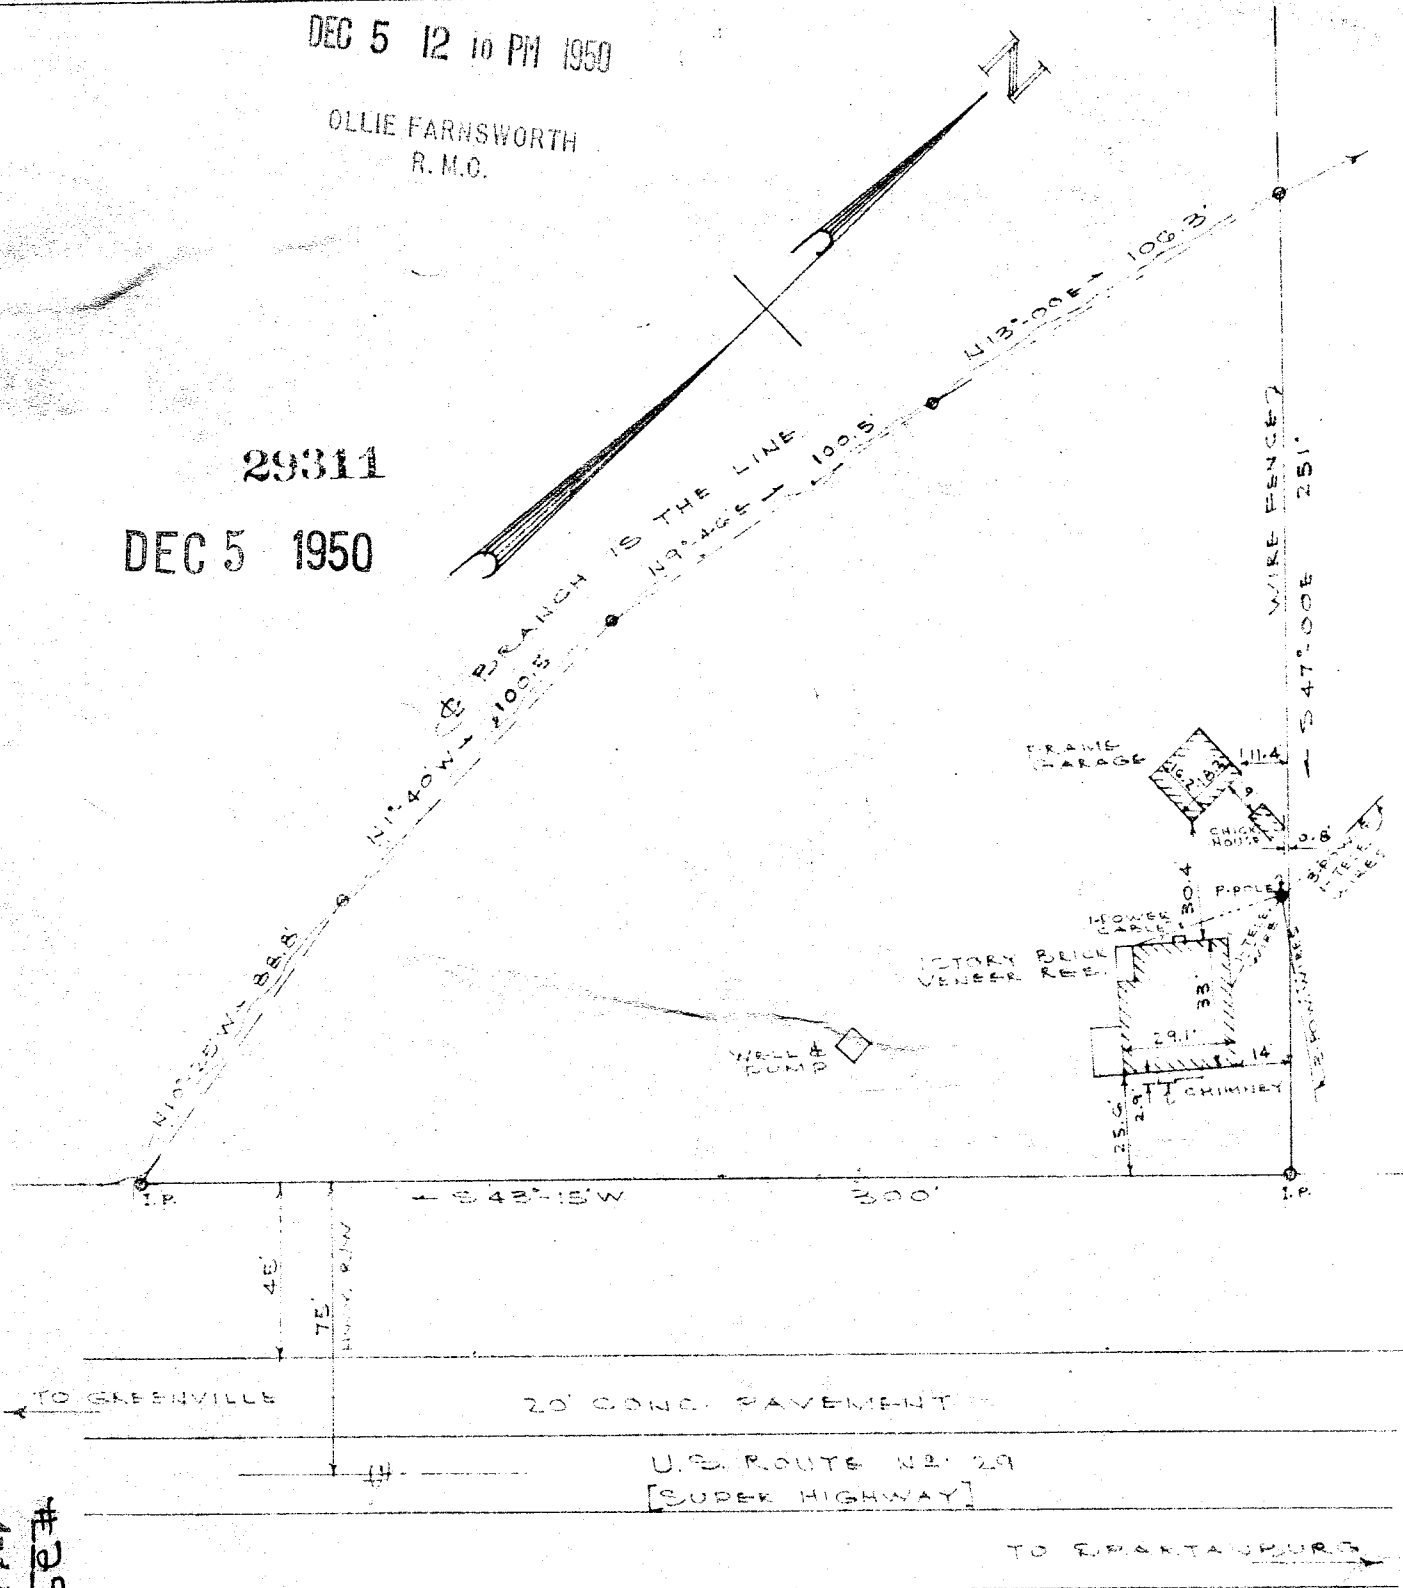

PROPERTY OF: _____

C. E. PEURIFOY

LOCATED IN "GREENVILLE COUNTY" NEAR THE
CITY OF GREENVILLE - S. C.

PICKELL & PICKELL - ENGINEERS
GREENVILLE - SOUTH CAROLINA

SCALE: 1" = 50'

DATE: OCT. 18, 1950

I hereby certify that the measurements as shown on
this plat are correct and there are no projections or
encroachments other than shown.

Hm Pickell

REG. ENGR.

#29311

Filed This 5th day of Dec 1950

And Recorded in Vol.

Page 93 at

M

Osia

Farnsworth

Register Mesne Conveyance Greenville County, S. C.

93