Plat Book Z Page 103

Z-103

29753

DEC 9 1950

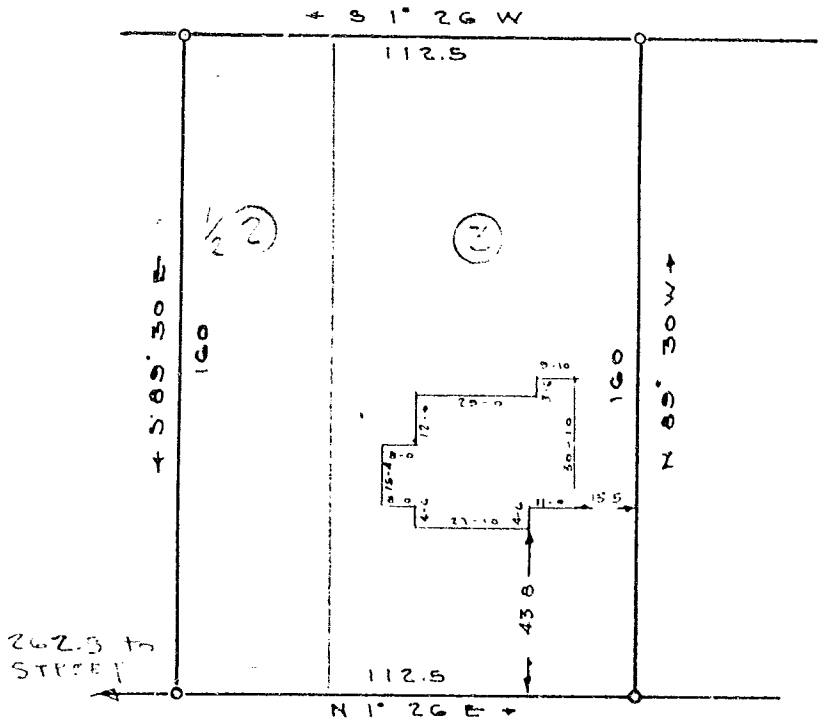

PROPERTY OF

CHARLES STERLING

GREENVILLE, S.C.

Scale 1"=40' Dec. 8-1950

NOTE:

This Plat Shows Lot 3 And Portion of Lot 2 of Original Survey of Lois M. Wilson Property by Piedmont Engineering Service 1947 See R.M.C office Pl. Bk T P. 120.

This is to Certify that on the 8 th day of December 1950, I surveyed the property shown on this plat: and that the property lines, walls and buildings located on said Lot do not encroach or project on adjacent Streets or property and that no adjacent buildings or walls encroach or project on said property.

C. C. Jones

Reg. Engr. No 1144

By C. C. JONES Reg Eng'r #1144

#29753 Filed this 9 day of Dec. 1950

and Recorded in Book 103 at 10 8 p.m.

Celia Samsworth