


JAN 20 1951

1616

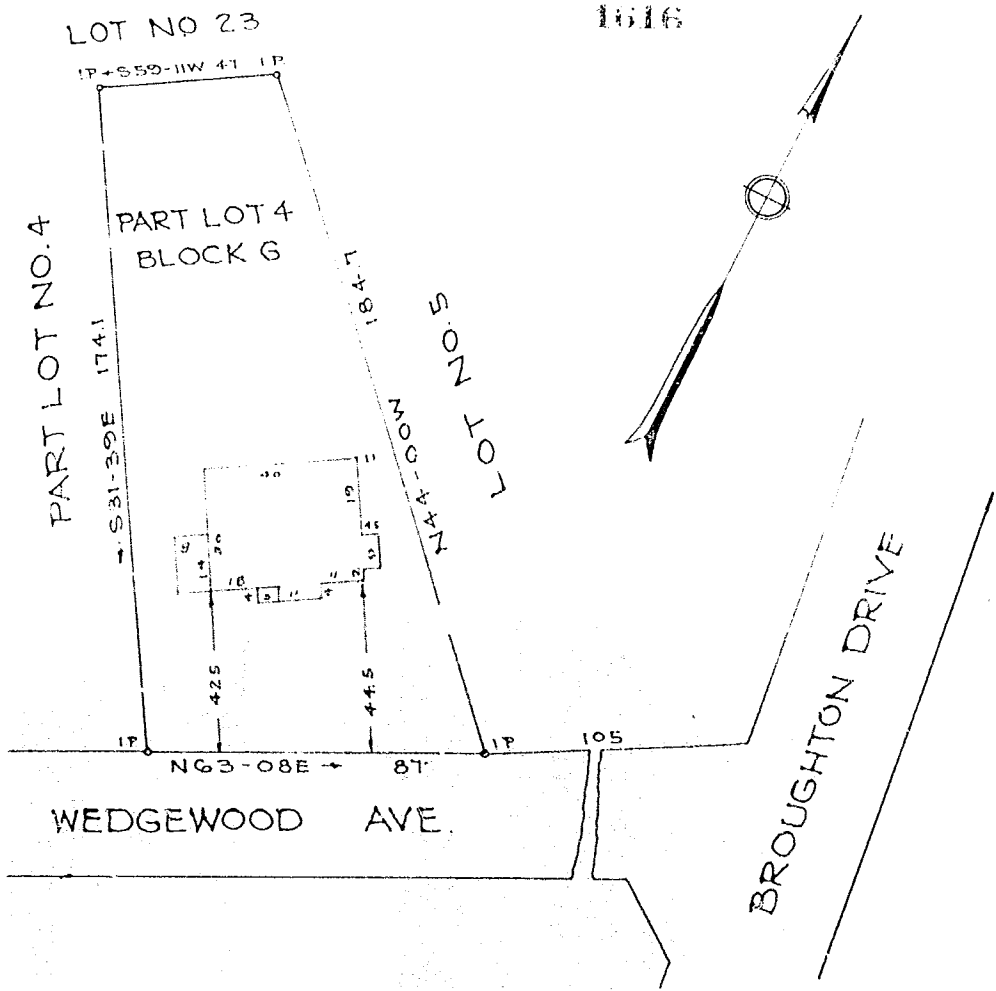

PROPERTY OF
 RUFUS M. DALTON
 GREENVILLE S. C.
 Scale 1"=40' Jan. 1951

This is to certify that on the 18th day of January, 1951, I surveyed the property shown on this plat; being known as part of Lot No. 4, Block G of Croftstone Acres, Recorded in Plat Book S pages 78-79, Office of R. M. C. Greenville Co., S. C. and that the property lines, walls and buildings are as shown hereon; that the buildings located on said lot do not encroach or project on adjacent streets or property; and that no adjacent buildings or walls encroach or project on said premises.

R. W. Dalton
 Registered.

1616 - Plat This 20 days of Jan. 1951
 And Recorded in Vol. 8 Page 135 of Plat B.A.R.M.
Celia H. Howard
 Register of Deeds Greenville County, S.C.

JAN 20 10 12 AM 1951
 GREENVILLE CO. S.C.
 DEPT. OF RECORDS

264

BAD COPY

125