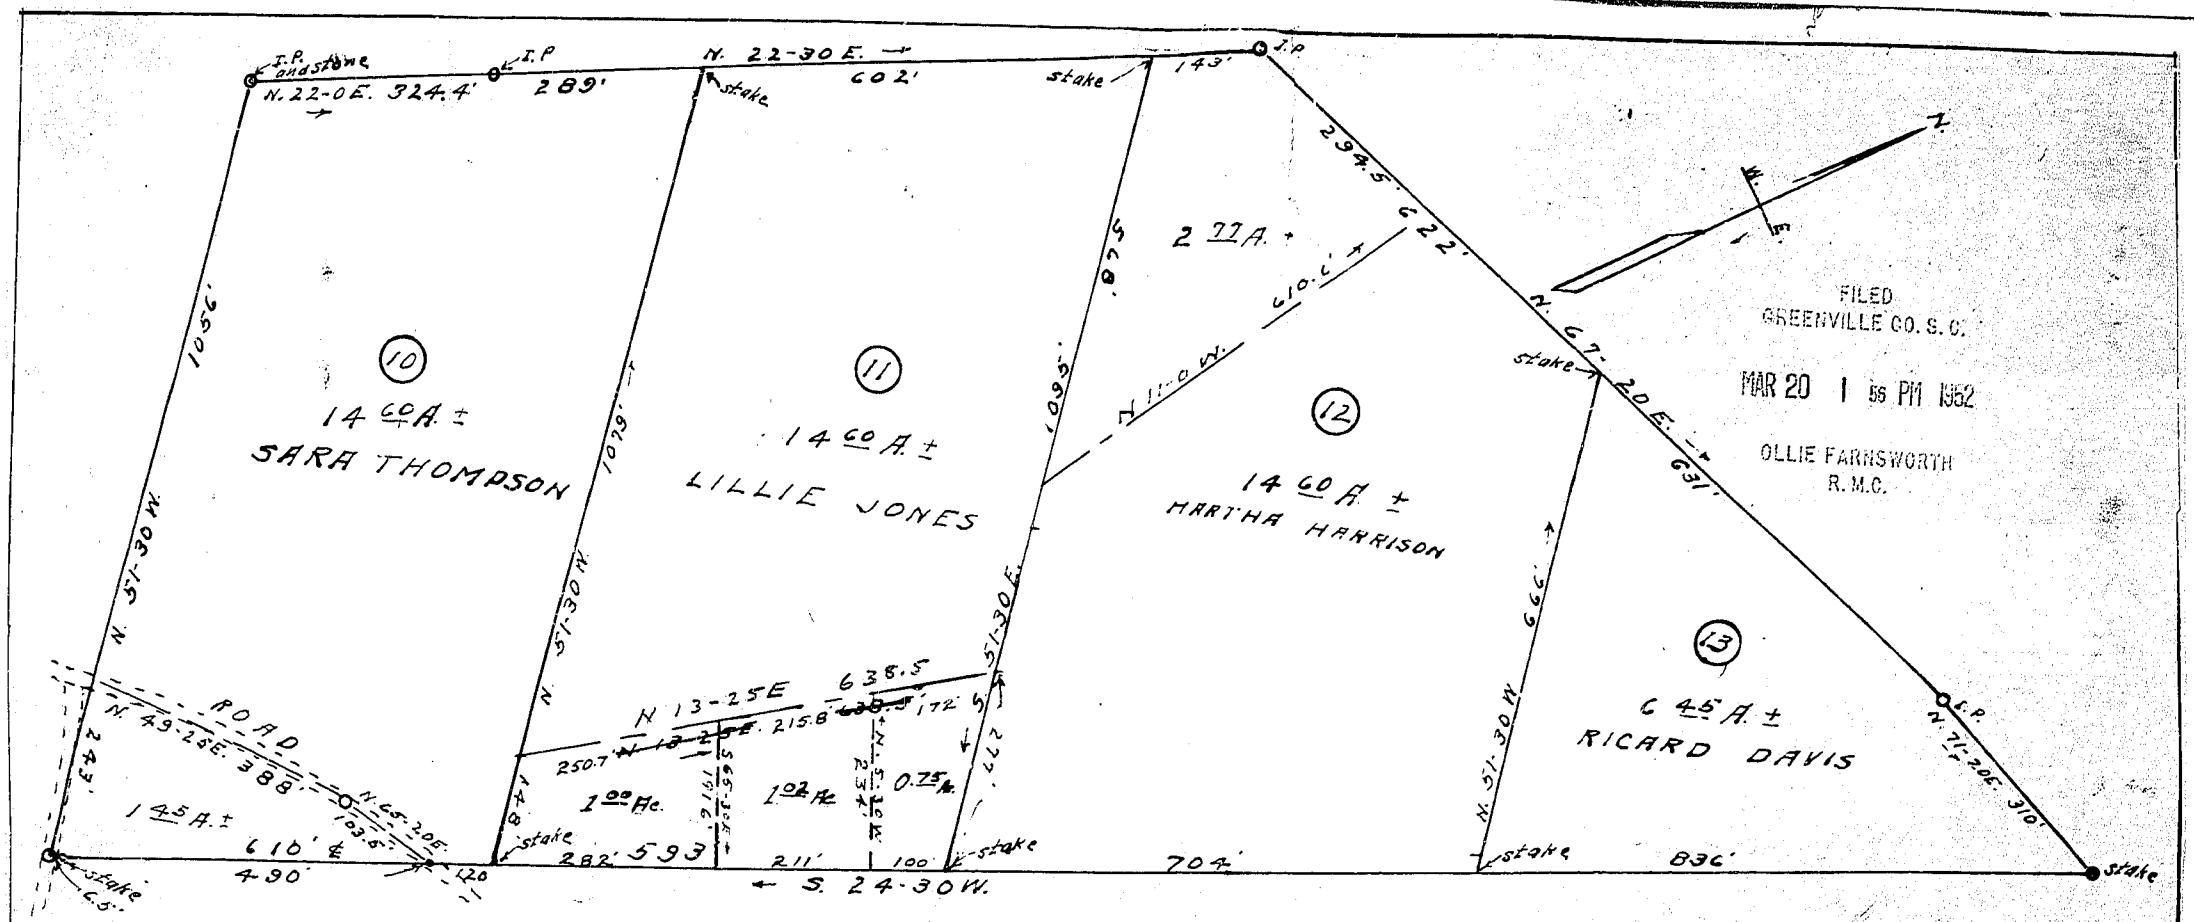

FILED
GREENVILLE CO. S. C.
MAR 20 1 56 PM 1952
OLLIE FARNSWORTH
R.M.C.

MAP NO. 2
PROPETY OF
LEMUEL DAVIS EST.

GREENVILLE COUNTY - S.C.

Scale 1" = 200' -------- Nov. 1944

W. J. Riddle - surveyor

Book H-50

"NOTE" Lots 10, 11 & 12 Divided and plat revised 1-6-50 By W. J. R.

2.77 Acre tract - portion of Lot No. 11, Divided and plat revised 2/14/52 by W. J. R.

BAD COPY
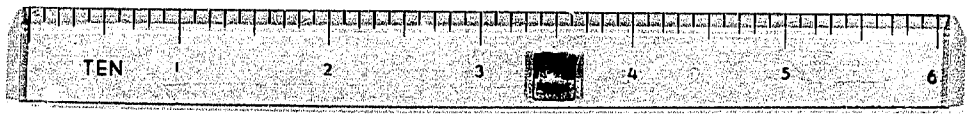
#6670 Filed This 20 day of March 1952
And Recorded in Vol. Z Page 108 at 11:56 P.M.
Ollie Farnsworth
Register Mesne Conveyance Greenville County, S. C.