Plat Book Z Page 185A

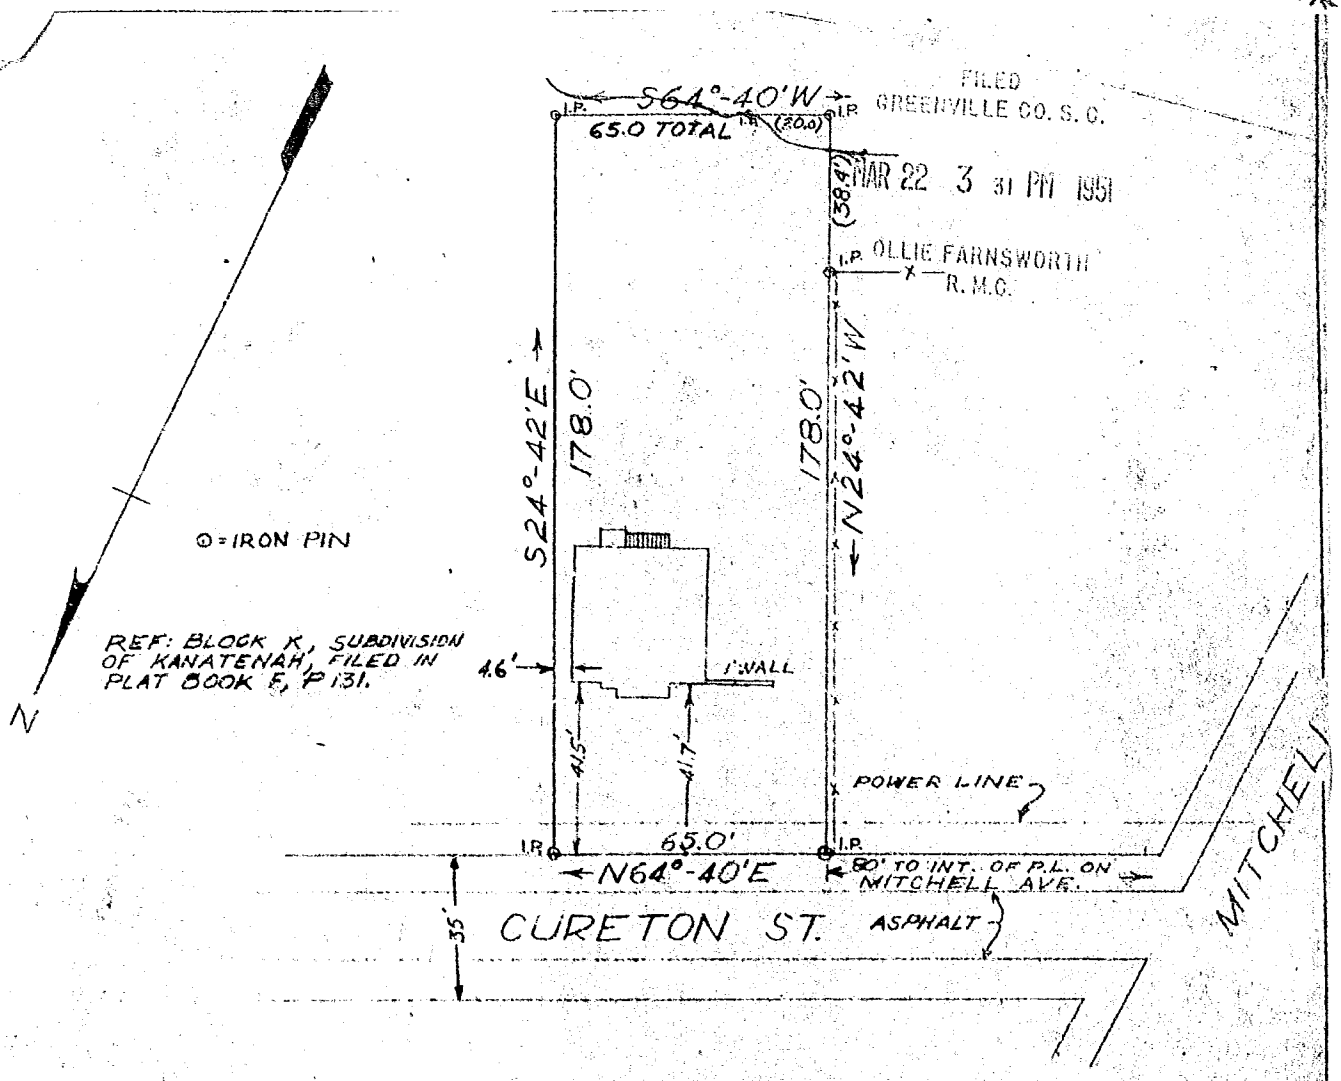

PROPERTY OF
GORDON B. GALBRAITH JR
CURETON ST. GREENVILLE, S.C.
SCALE: 1"=40' 17 MAR 1951

MAR 22 1951 6700

This is to certify that on the 17th day of March, 1951 I surveyed the property shown on this plat; and that the property lines, walls and buildings are as shown hereon; that the buildings located on said lot do not encroach or project on adjacent streets or property; and that no adjacent buildings or walls encroach or project on said premises.

A. Clouch
Registered Engineer # 808

PIEDMONT ENGINEERING SERVICE
GREENVILLE S.C.

B5P11

#6700 Filed This 22 day of March 1951
And Recorded in Vol. Z Page 185 at 3:31 P.M.
Ollie Farnsworth
Register Mesne Conveyance Greenville County, S. C.

BAD COPY