


FILED
GREENVILLE CO., S. C.

MAR 25 12 44 PM 1953

OLLIE FARNSWORTH
R. M. C.

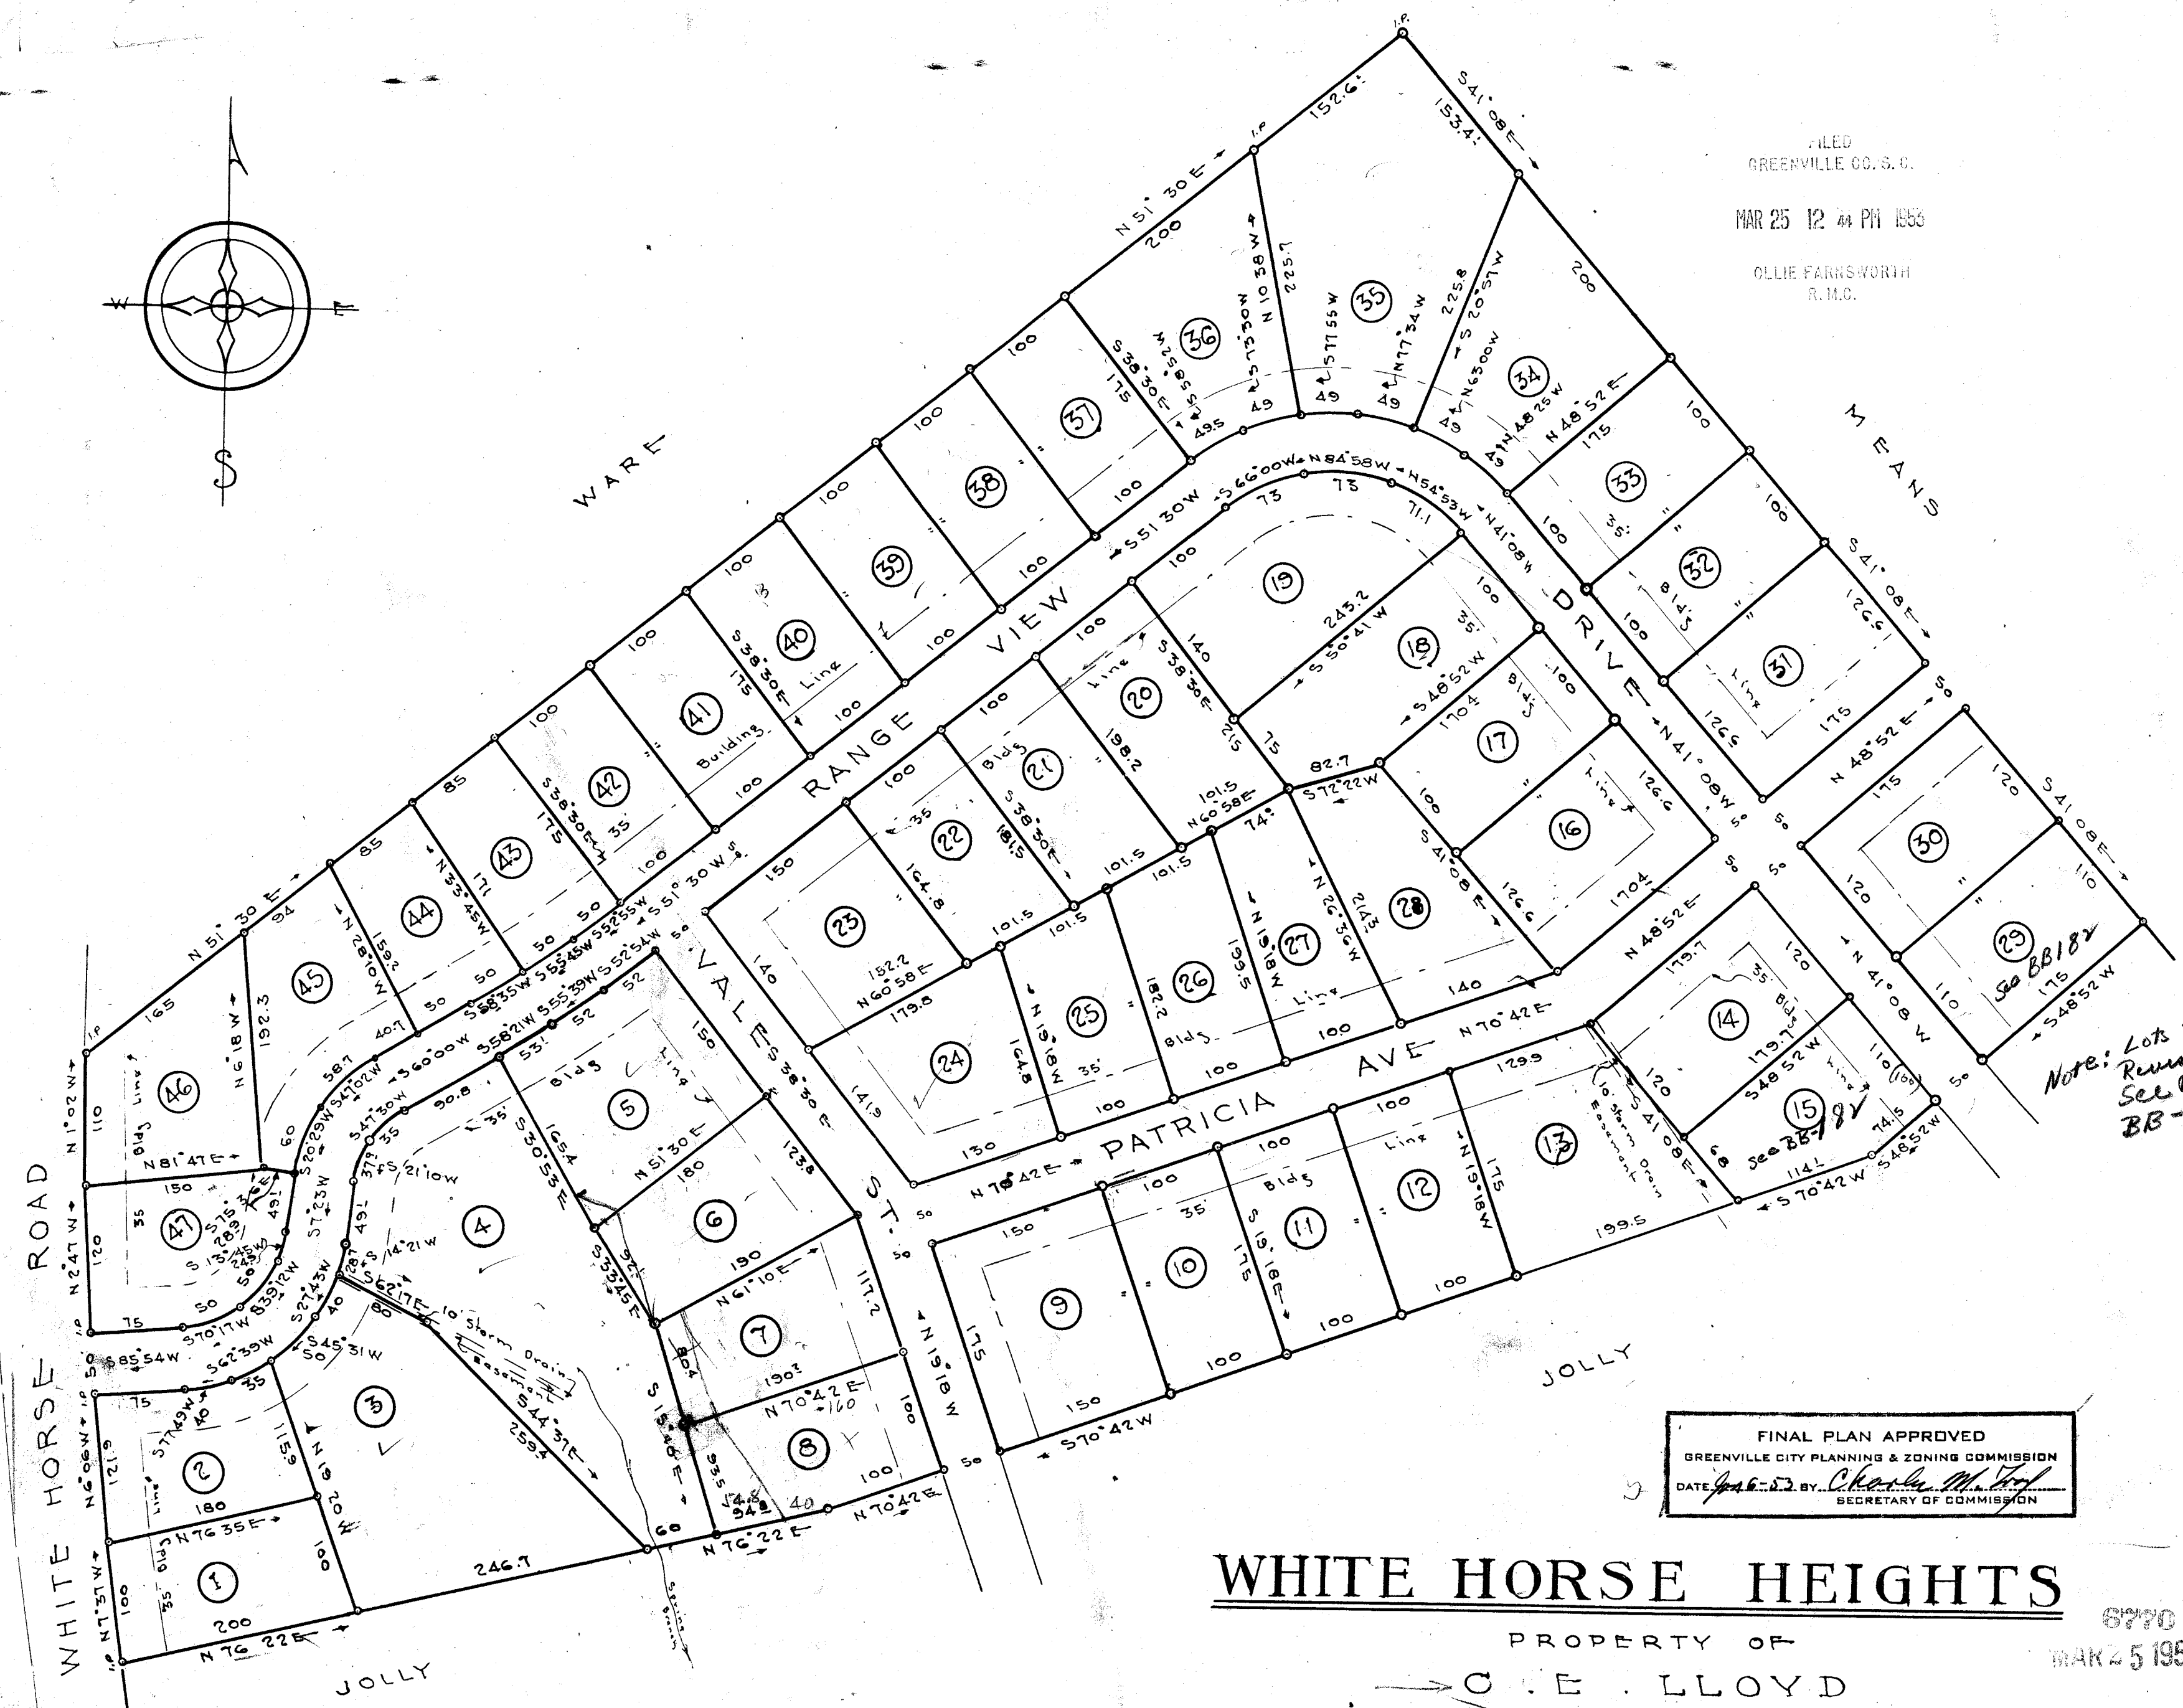

Note: Lots 29-31
Remain -
See Plat at
BB-182

FINAL PLAN APPROVED
GREENVILLE CITY PLANNING & ZONING COMMISSION
DATE: *Jan 22* BY: *Charles M. Wolf*
SECRETARY OF COMMISSION

WHITE HORSE HEIGHTS

PROPERTY OF
C. E. LLOYD
NEAR

GREENVILLE, S. C.

Scale 1" = 100' Dec. 20, 1952

6770
MAR 25 1953

6770 Filed this 25 day of March 1953
And Recorded in Vol. BB Page 135 at
Olivia Sammons
Register Means Conveyance Greenville County, S. C.

BB-135

C. C. JONES
CIVIL ENGINEER
GREENVILLE, S. C.

Iron pins placed at all corners