


Plat Book-BB-Page 163

20102

SEP 9 - 1954

1120402 Filed This 9 day of Sept 1954
And Recorded in Vol. B.B. Page 163 at 11 A.M.
C. S. Samsel, Jr.
Register Main: Chaucance Greenville County, S. C.

BAD COPY

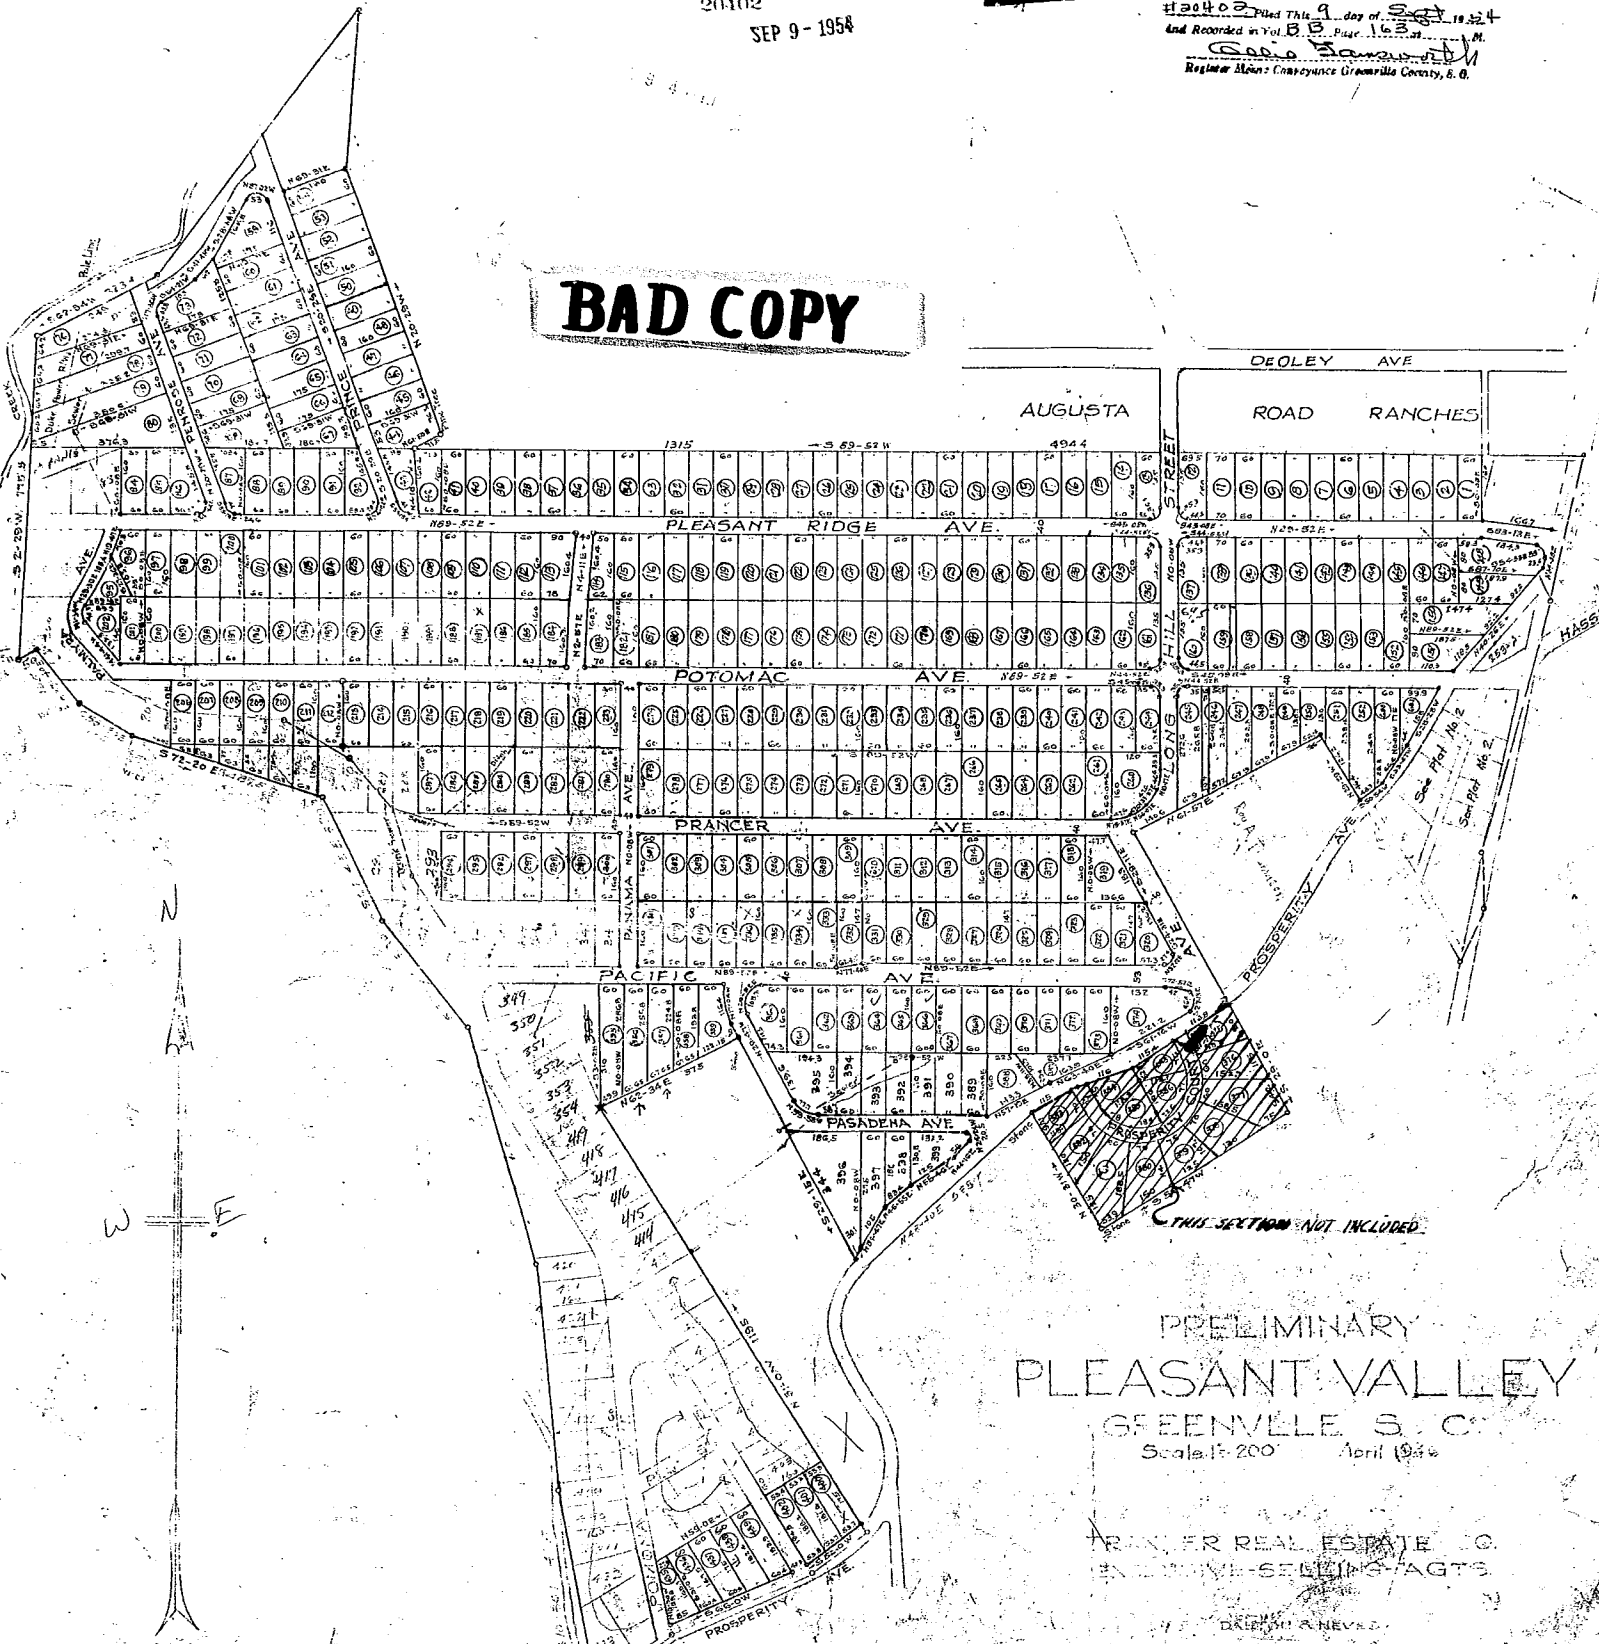

PRELIMINARY
PLEASANT VALLEY
 GREENVILLE S. C.
 Scale: 1" = 200' April 1946

TRINER REAL ESTATE CO.
 EXCLUSIVE-SELLING-AGTS

DAVENPORT & NEVILL

Addition to Map made Nov. 1948

Addition to Map made June 1946

Lots 113-114 & 187 Revised Sept. 1948

155-2-46 Aug 1945

Addition to Plat made Feb. 1950 (Lots 281-294-300)

Addition to Plat made Dec. 1952 (Lots 44-54)

59-73-74-80

Addition of Lots 95-96-202 made Jan. 1953 (Plat 275)

389-393 lots made July 1954 - 292

893-441

FINAL PLAN APPROVED
 GREENVILLE CITY PLANNING & ZONING COMMISSION
 DATE: SEP 2 1954
 SECRETARY OF COMMISSION

numbered in Circles have been staked with Iron Pins

3-148-227-228

