


FILED
GREENVILLE CO. S. C.

DEC 6 10 45 AM 1954

OLLIE FARNSWORTH
R. M. C.

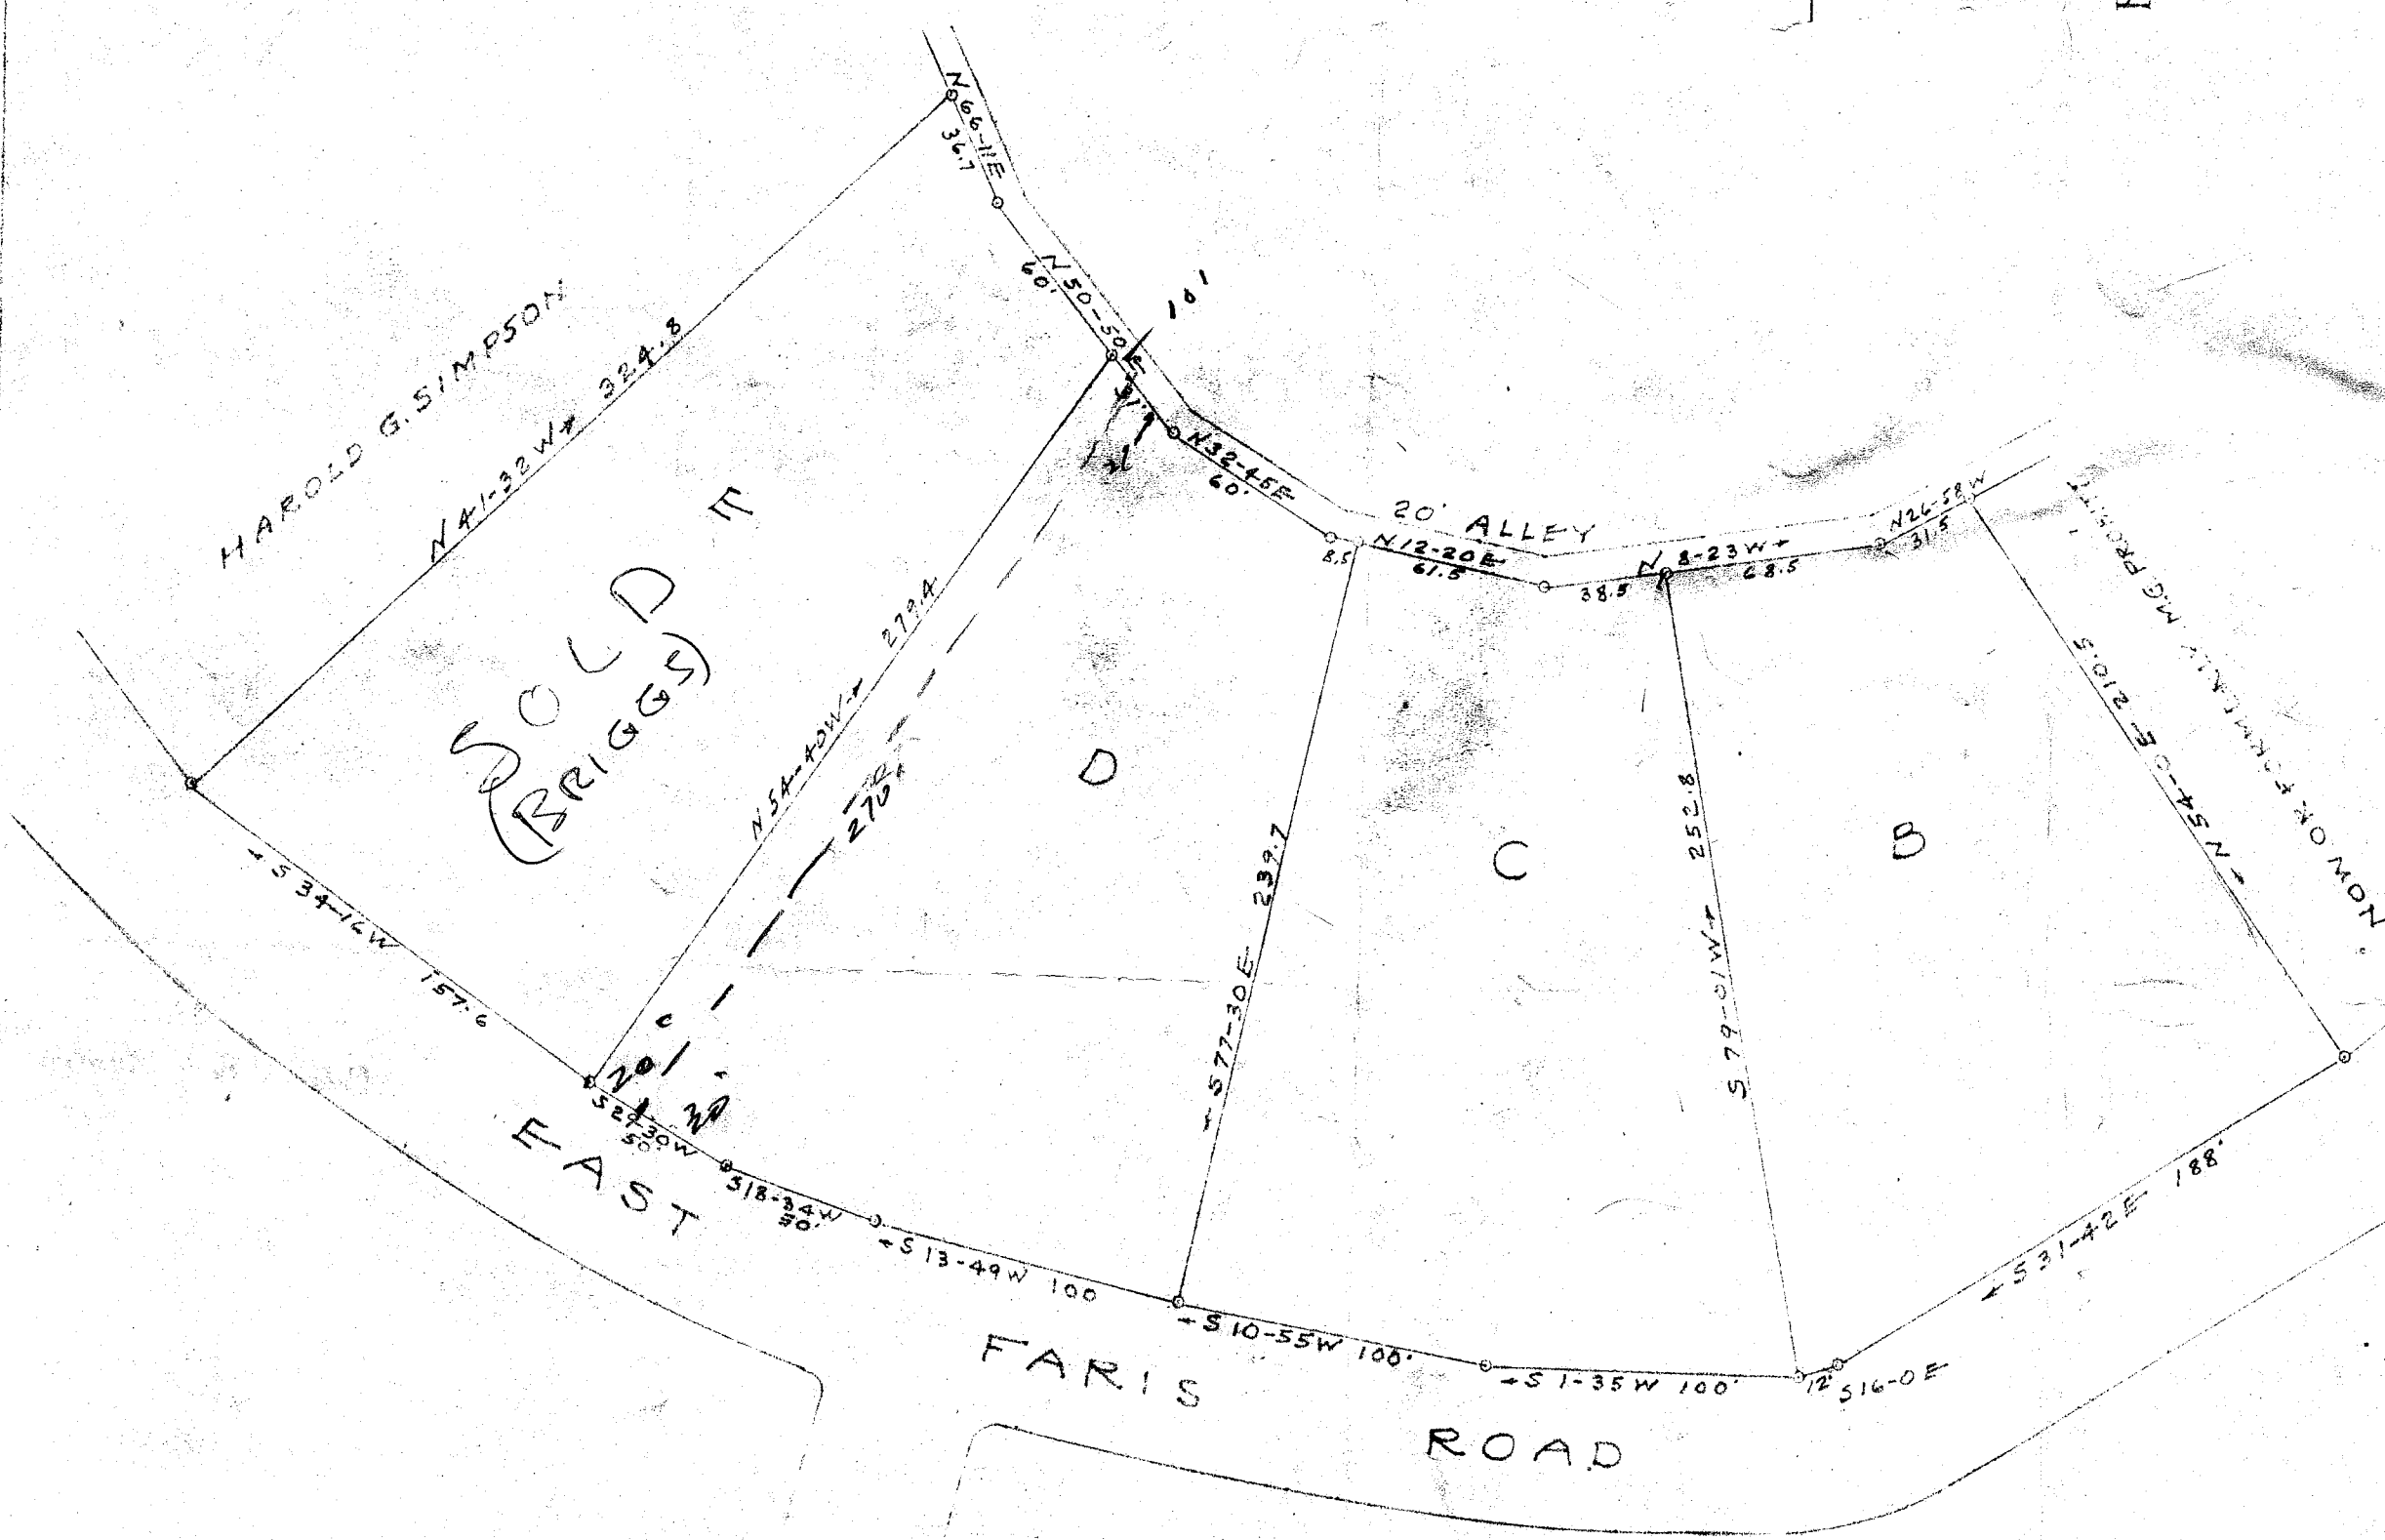

#27872 Filed This 6 day of Dec. 19 54
And Recorded in Vol. CC Page 6 M.
Ollie Farnsworth
Register Meane Conveyance Greenville County, S. C.

DEC 6 1954
27872

REVISED PLAT
FOREST HEIGHTS
GREENVILLE SC
SCALE 1" = 60' AUG. 27, 1953

Plat Book 44, page 6