


# Plat Book-CC-Page 49A

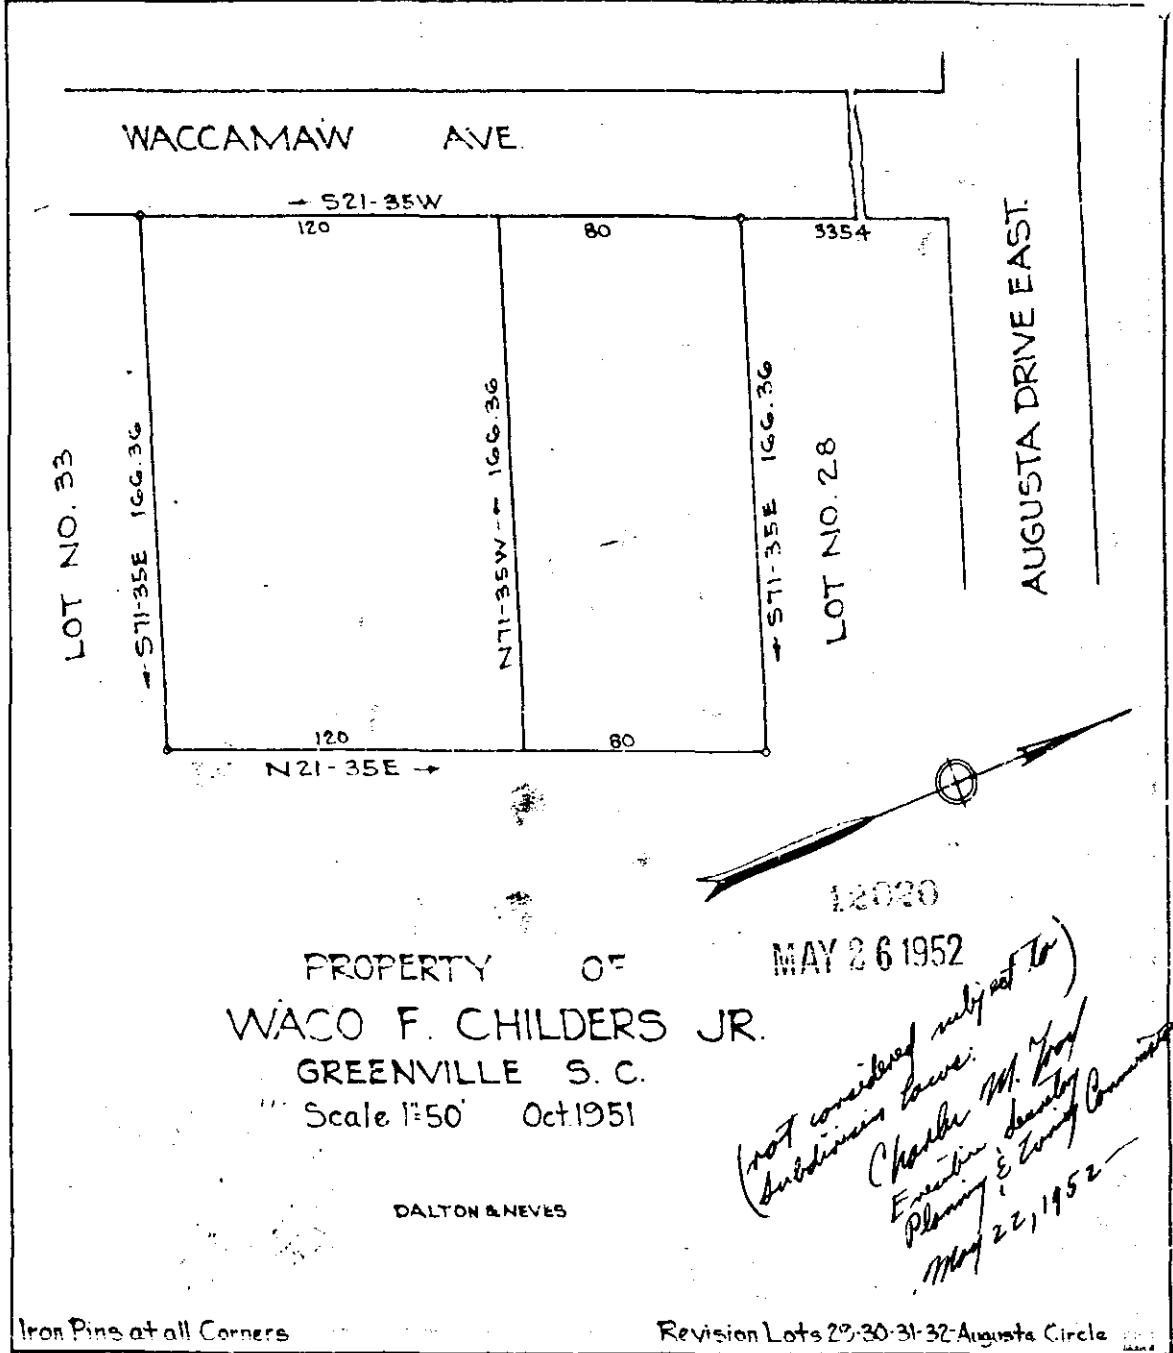

Iron Pins at all Corners

Revision Lots 27-30-31-32 Augusta Circle

#12020 Made This 26 day of May 1952

And Recorded in Vol. CC Page 49 at

*Rollie Hunsworth*

Register of Deeds Greenville County S. C.