
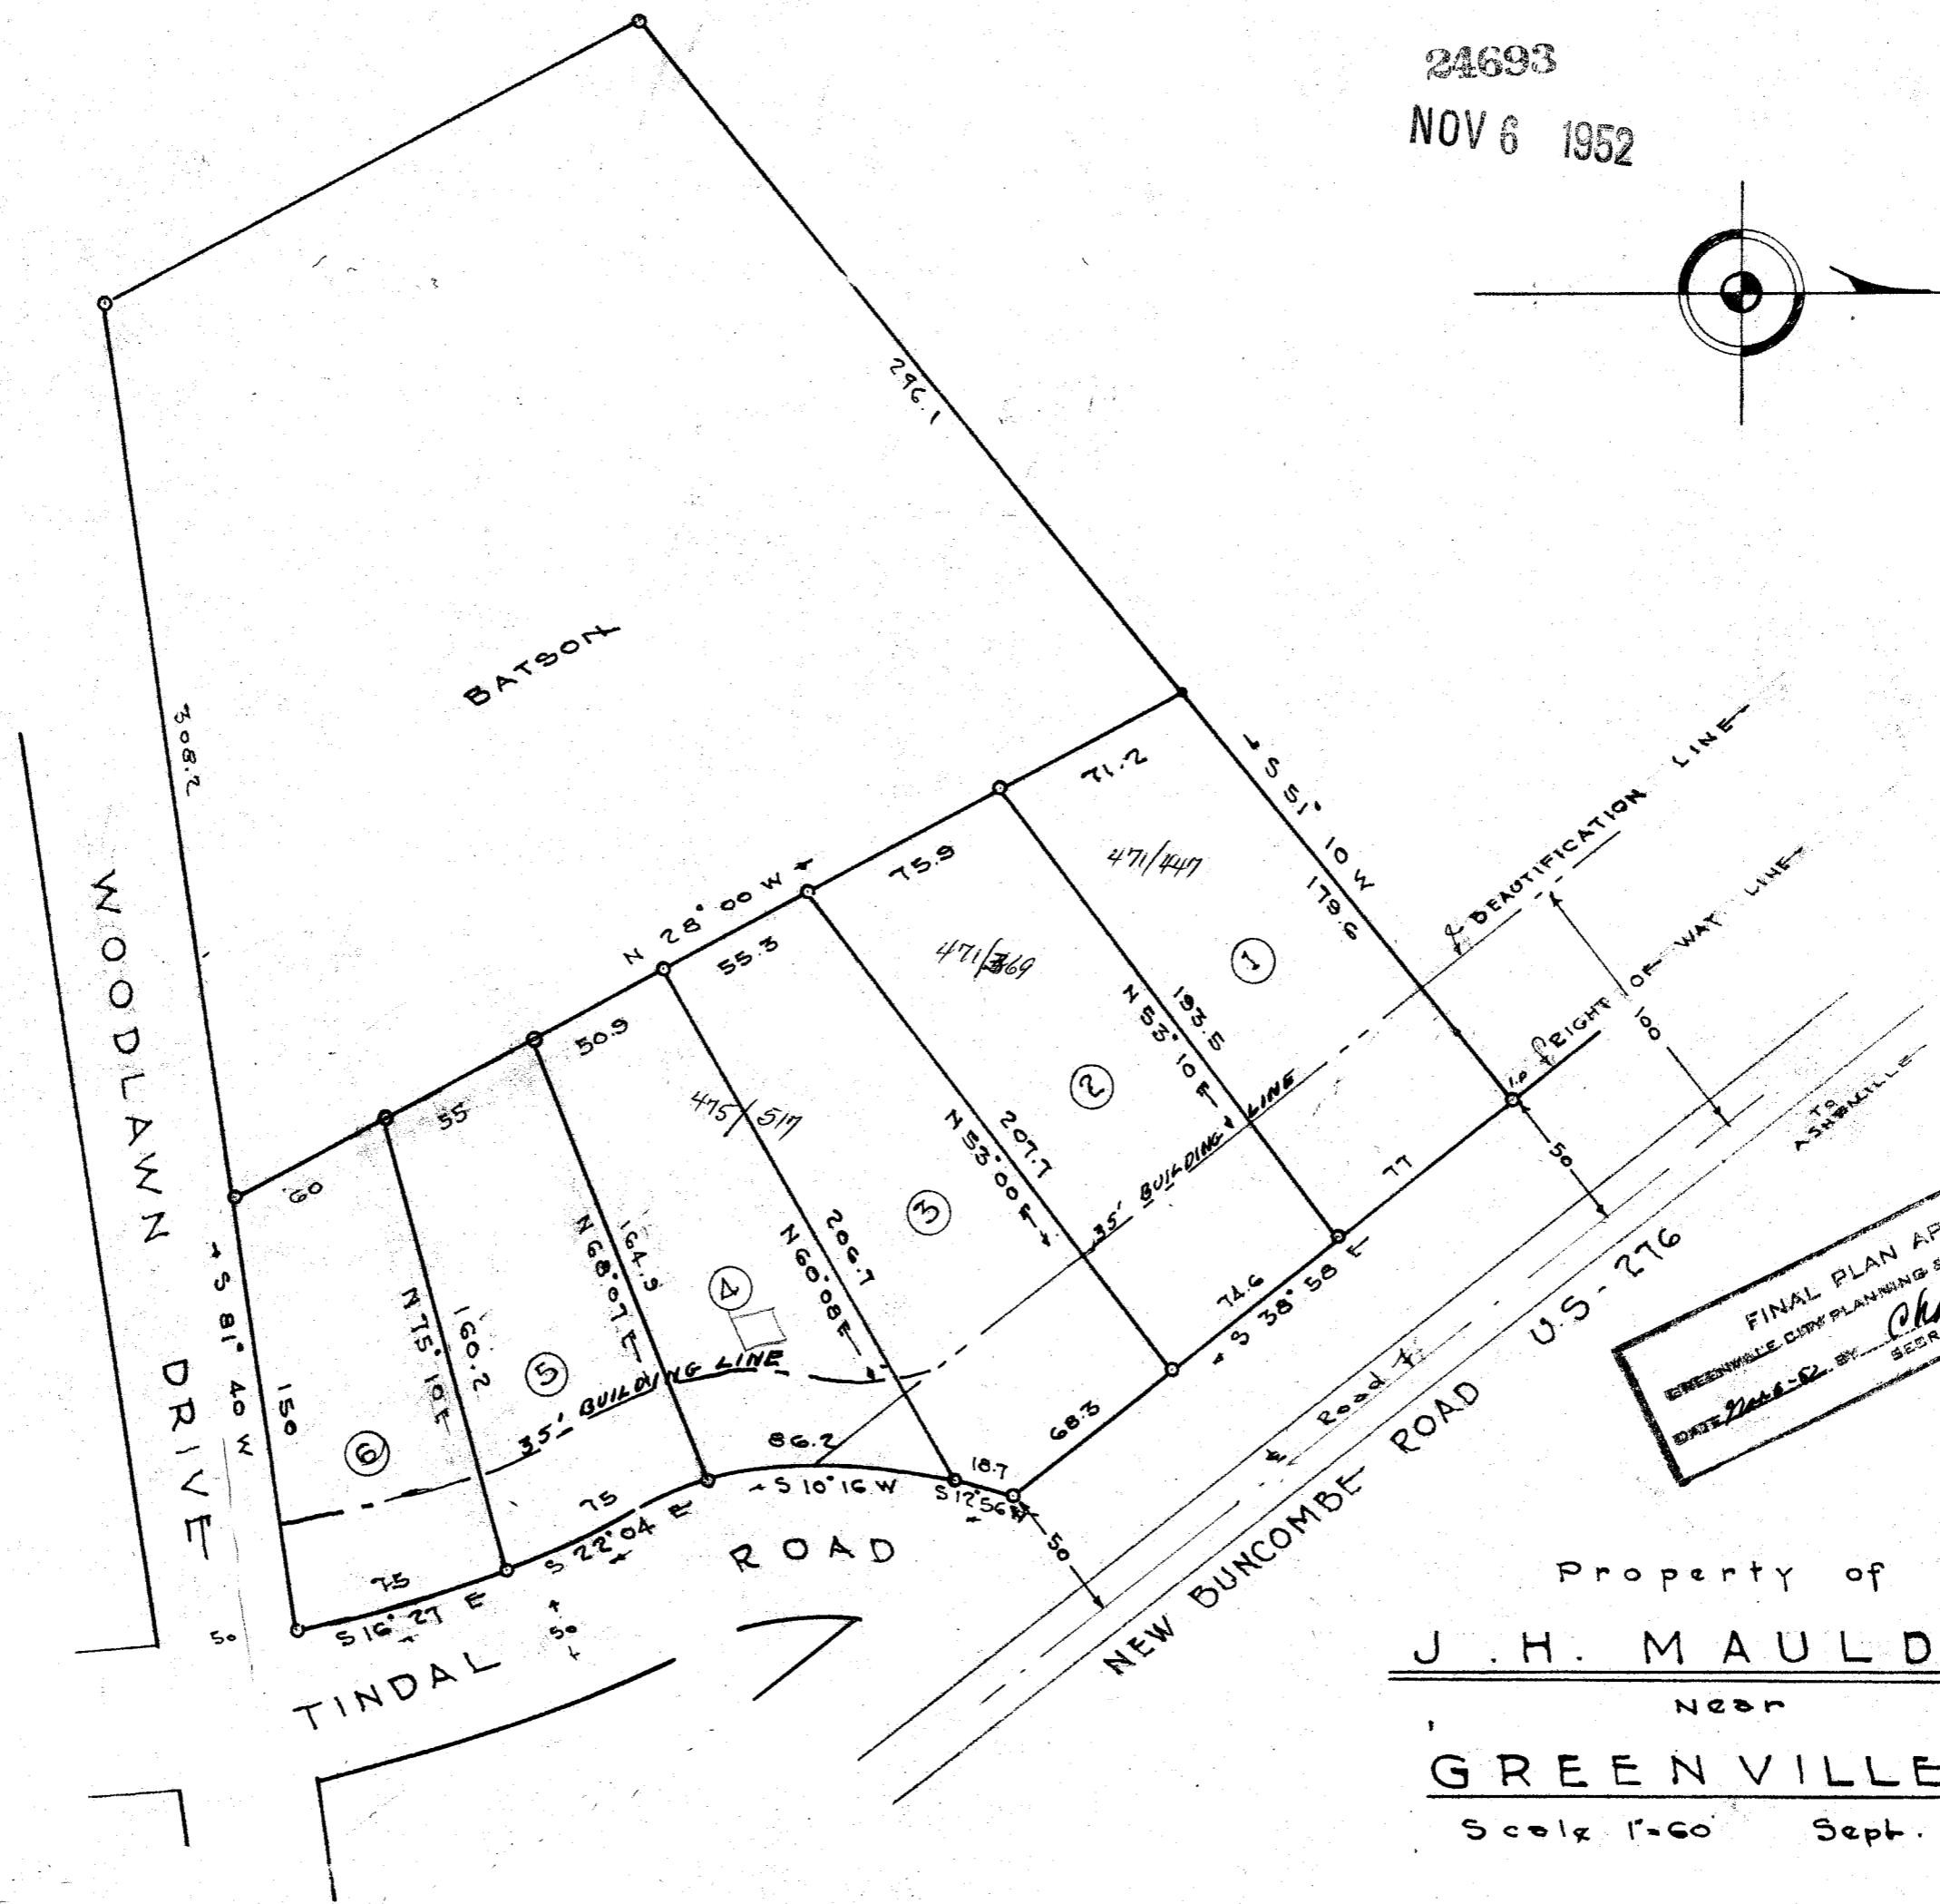


444 p 38

24693
NOV 6 1952

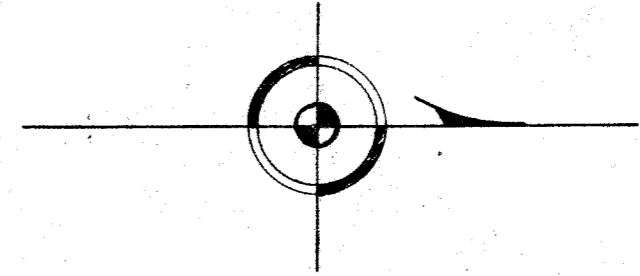

FINAL PLAN APPROVED
GREENVILLE CITY PLANNING & ZONING COMMISSION
DATE 2-26-52 BY *Charles M. York*
SECRETARY OF COMMISSION

Property of
J. H. MAULDIN
Near
GREENVILLE, S.C.

Scale 1"=60' Sept. 1952

C. C. JONES
CIVIL ENGINEER
GREENVILLE, S.C.

Iron pins at all corners

NOTE: Revision in Lots 4-5-6 (Nov-6-1952)

#24693 Filed This 6 day of Nov 1952
And Recorded in Vol. 159 Page 159
C.C. Jones
Register Means Conveyance Greenville County, S.C.