


REF. PLAT OF WARD STONE (UNRECORDED) &
 PLAT OF NORTHGATE, UTOPIAN DEVELOPING CO., FILED IN PL. BK "M," PAGE 13.

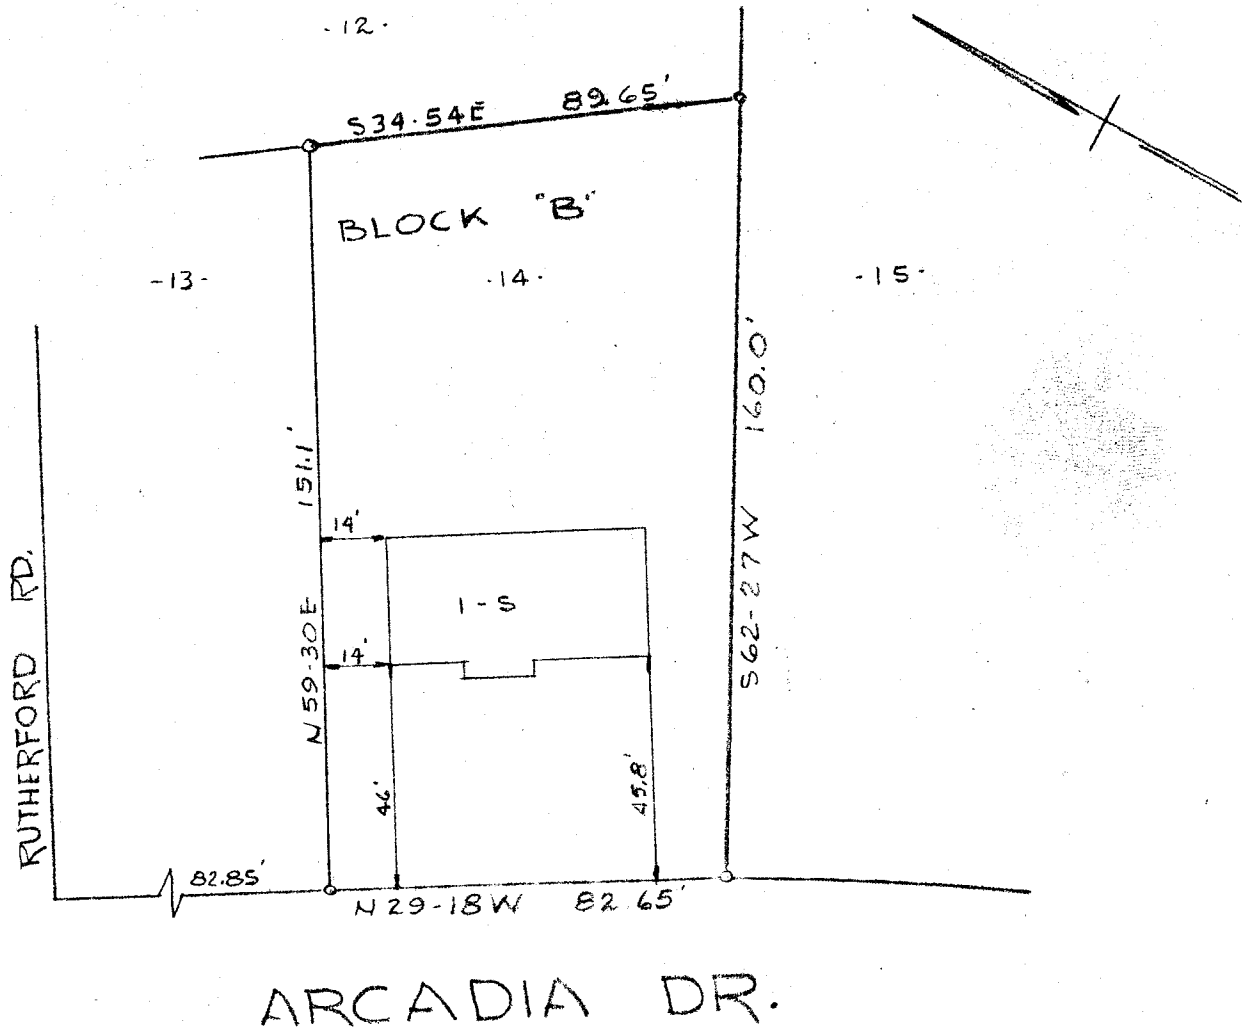

PROPERTY OF
C. ALEX STAHL
 GREENVILLE SC.
 SCALE 1" = 40 FT. 30 Oct 1952

This is to certify that on the 30th day of October 1952, I surveyed lot 14, Plat of Ward Stone (Unrecorded) and Plat of Northgate, Utopian Developing Co., filed in Plat Book "M", page 13; and that the property lines, walls and buildings are as shown hereon; that the buildings located on said property do not encroach or project on adjacent streets or property; and that no adjacent buildings or walls encroach or project on said premises.

C. Alex Stahl
 Registered Engineer No. 962

PIEDMONT ENGINEERING SERVICE
 GREENVILLE, S. C.

BSOR

#24522 ~~Plat~~ ~~the~~ ~~4~~ ~~of~~ ~~the~~ ~~to~~ ~~52~~
 and Recorded in Vol. 22 Page 197 at 5:30 P.M.
Colie Farnsworth
 Register Mesne Conveyance, Greenville County, S.C.