

MAR 9 12 12 PM 1953

OLLIE FARNSWORTH
R.M.C.

LOTS 14-1 BLOCK "H"

TOWNE'S
ST.

6433
MAR 9 1953

Lots # 7 thru 11 have been replatted as
property of J.H. Mauldin, platted by C.C. Jones, Oct. 1952

204.8
126.9
525.7

SURETY MORTGAGE CO.
PROPERTY

FINAL PLAN APPROVED
GREENVILLE CITY PLANNING & ZONING COMMISSION
DATED 4-5-53 BY *Charles M. Ford*
SECRETARY OF COMMISSION


SUBDIVISION
FOR

C. C. HINDMAN JR., DOROTHY M.
DAVENPORT, HILDA H. CARVER
& HENRY L. HINDMAN

LOCATED IN THE CITY OF
GREENVILLE, S.C.

PICKELL & PICKELL, ENGRS.
GREENVILLE, S.C.

SCALE: 1"=100' DATE: NOV. 1950

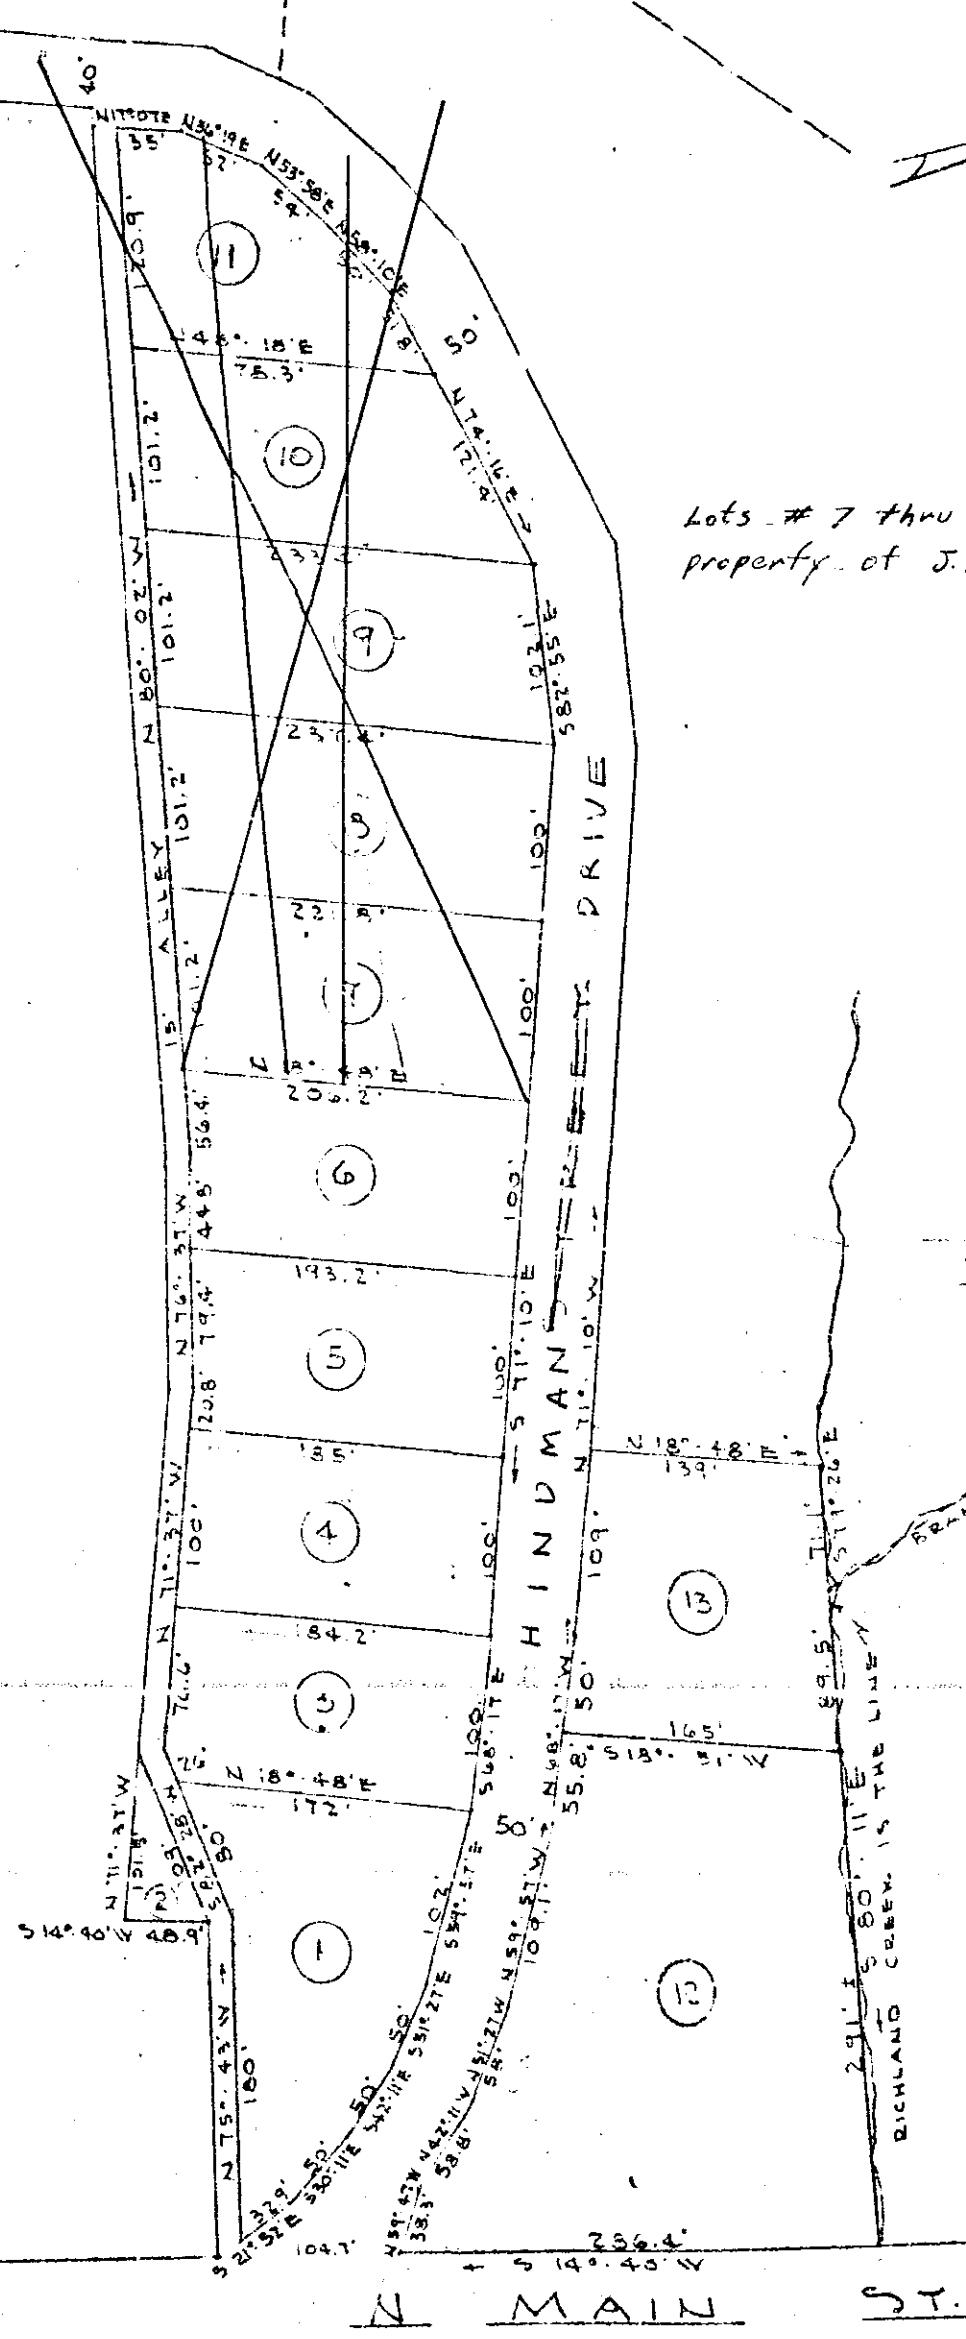

5433 Piled This 9 day of March 1953

and Recorded in Vol DD Page 177 at

Ollie Farnsworth

Register Meane Conveyance Greenville County, S. C.