


NB 112
SUBJECT #1

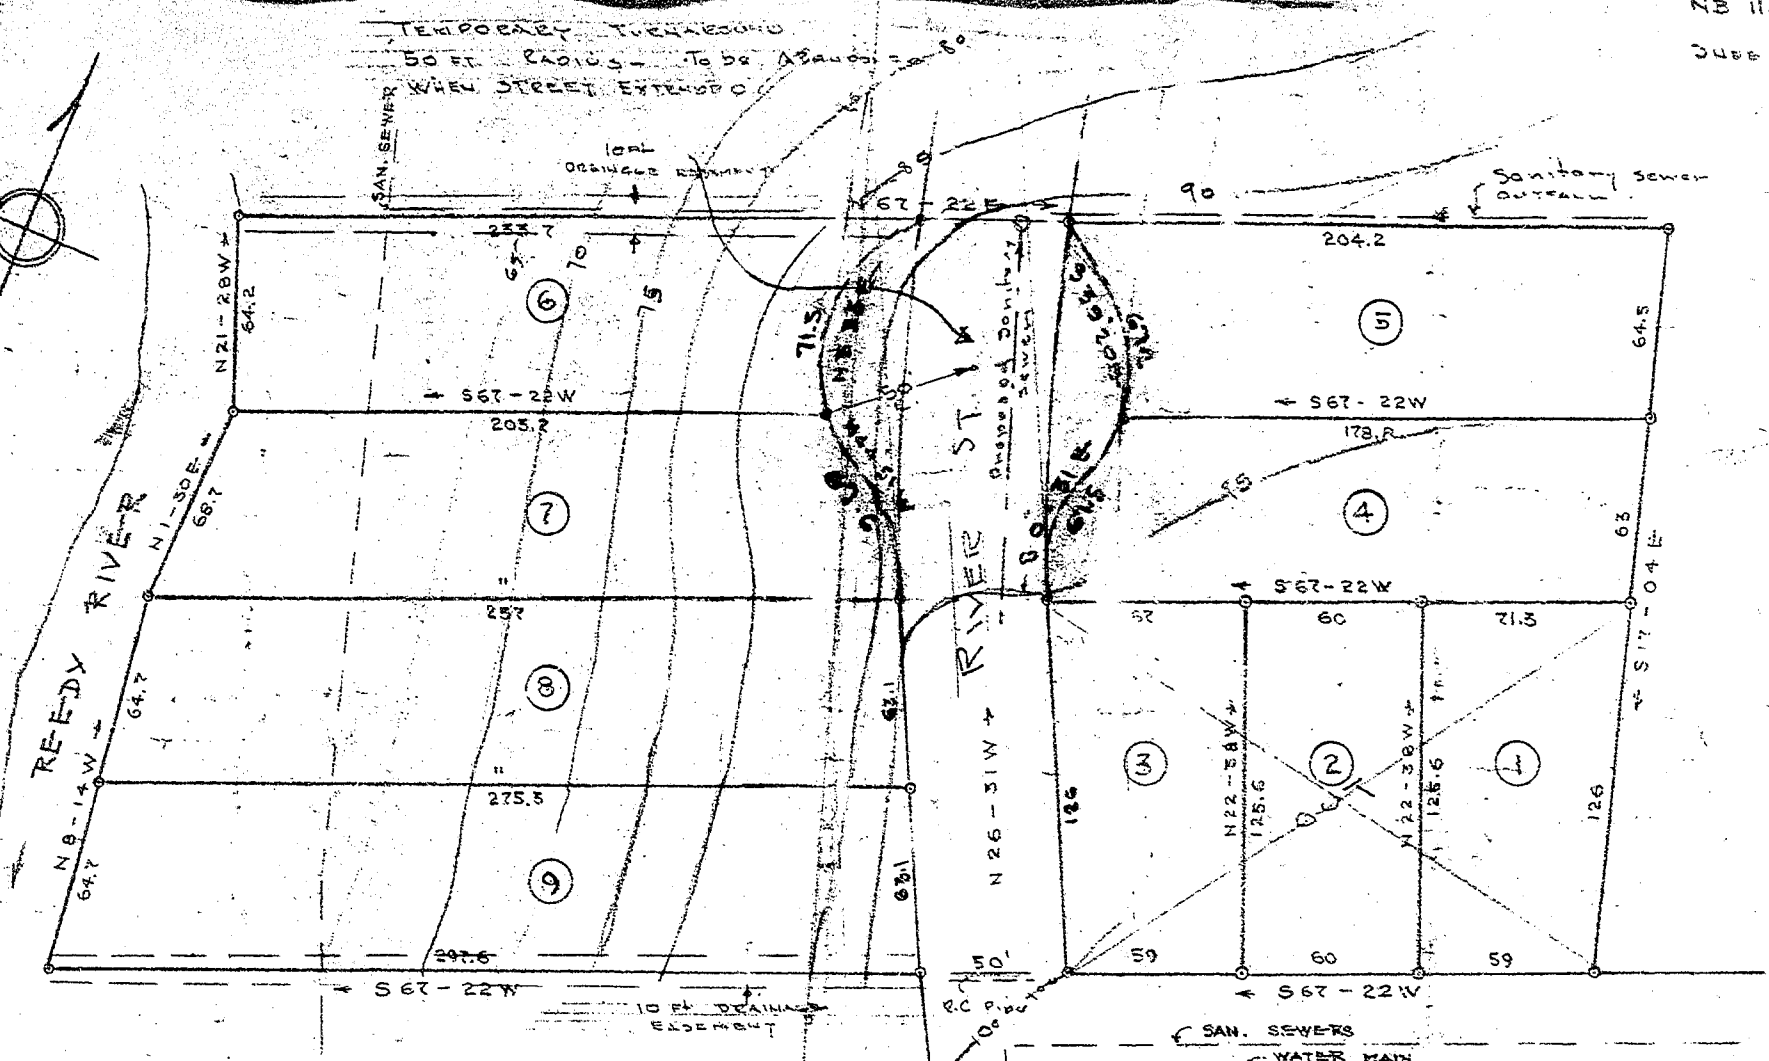

OK. A. Carter
City Engineer

PROPERTY OF
D. U. MAULDIN
GREENVILLE, S.C.
SCALE 1"=50' AUG. 4 - 1954

FINAL PLAN APPROVED
GREENVILLE CITY PLANNING & ZONING COMMISSION
DATE 3/25/55 BY Esther L. Rodgers
SECRETARY OF COMMISSION

SAN. SEWERS
WATER MAIN
HALL STREET

RIVER STREET

MAR 26 1955

7786

GREENVILLE, S.C.
MAR 25 11 05 AM 1955
OLIE FARNSWORTH
P.M.S.
C. C. JONES
CIVIL ENGINEER
GREENVILLE, S.C.

#7786 Filed This 26 day of March 1955
And Recorded in Vol. EE