



Plat Book - EE - Page 78

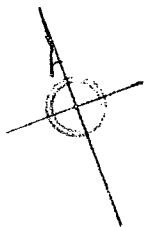

SCRUGGS

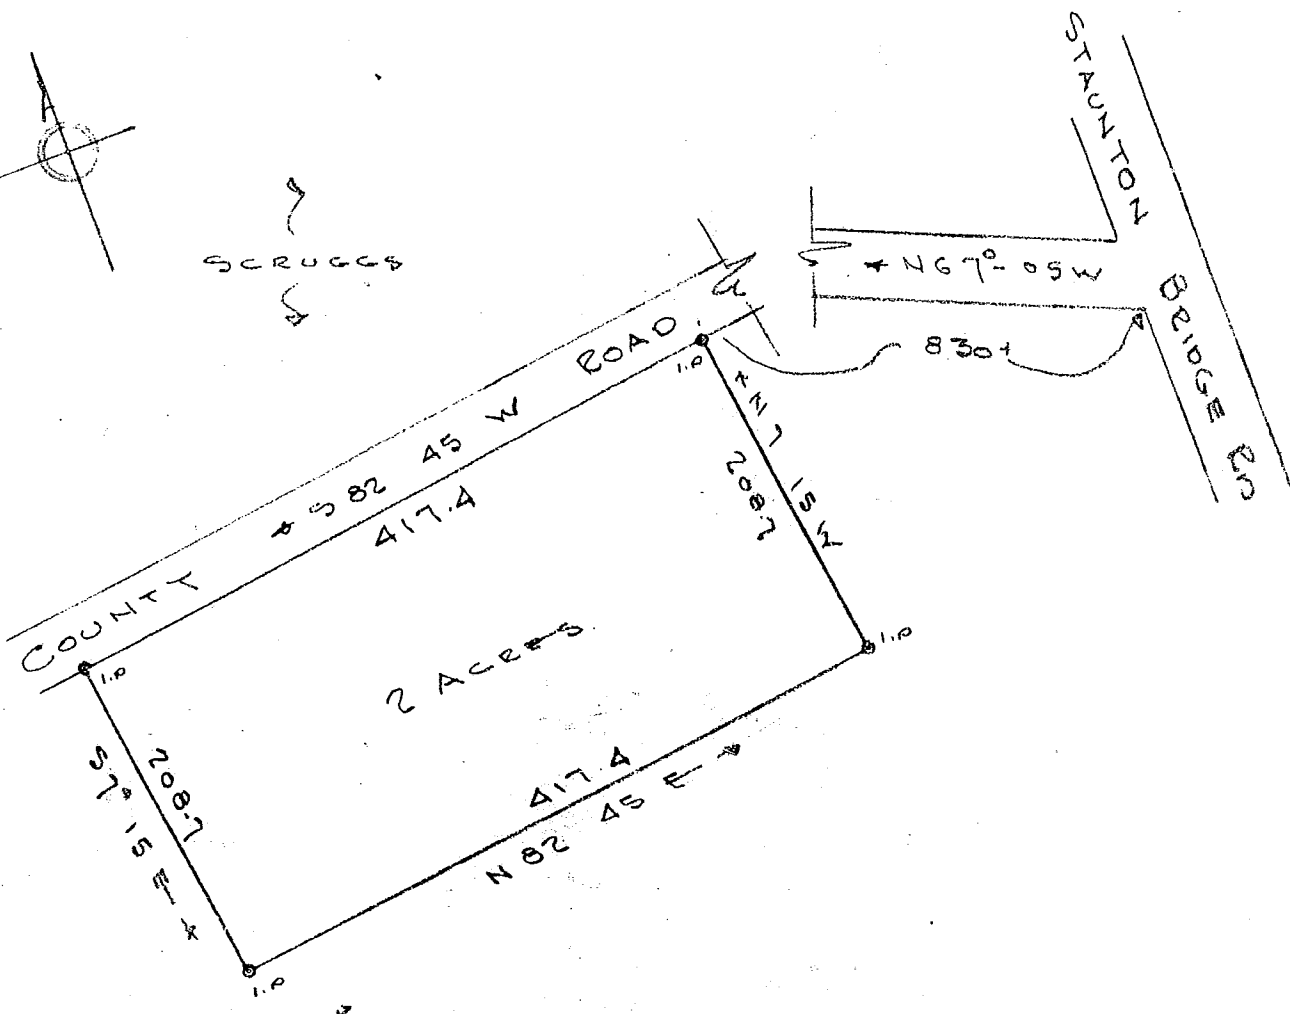

FILED
GREENVILLE CO. S.C.

OCT 13 11 04 AM 1955

OLLIE FARNSWORTH
R. M. C.

Property of
HOYT L. THREATT
GREENVILLE CO. S.C.

SCALE 1"=100' OCT - 5 - 1955

PART OF T. A. HOFF PROP.
SEE PLAT PROPERTY OF
RUPERT CRUGGS & T. A. HOFF
GREENVILLE CO. BY DALTON & HOWES
FEB - 1927

26610

OCT 13 1955

C. C. JONES & ASSOCIATES
ENGINEERS
GREENVILLE, S. C.

EE-78

#26640 filed This 13 day of Oct. 1955
And Recorded as EE 78
Ollie Farnsworth
Register Meane Commission Greenville County, S. C.

