Plat Book-EE-Page 95B

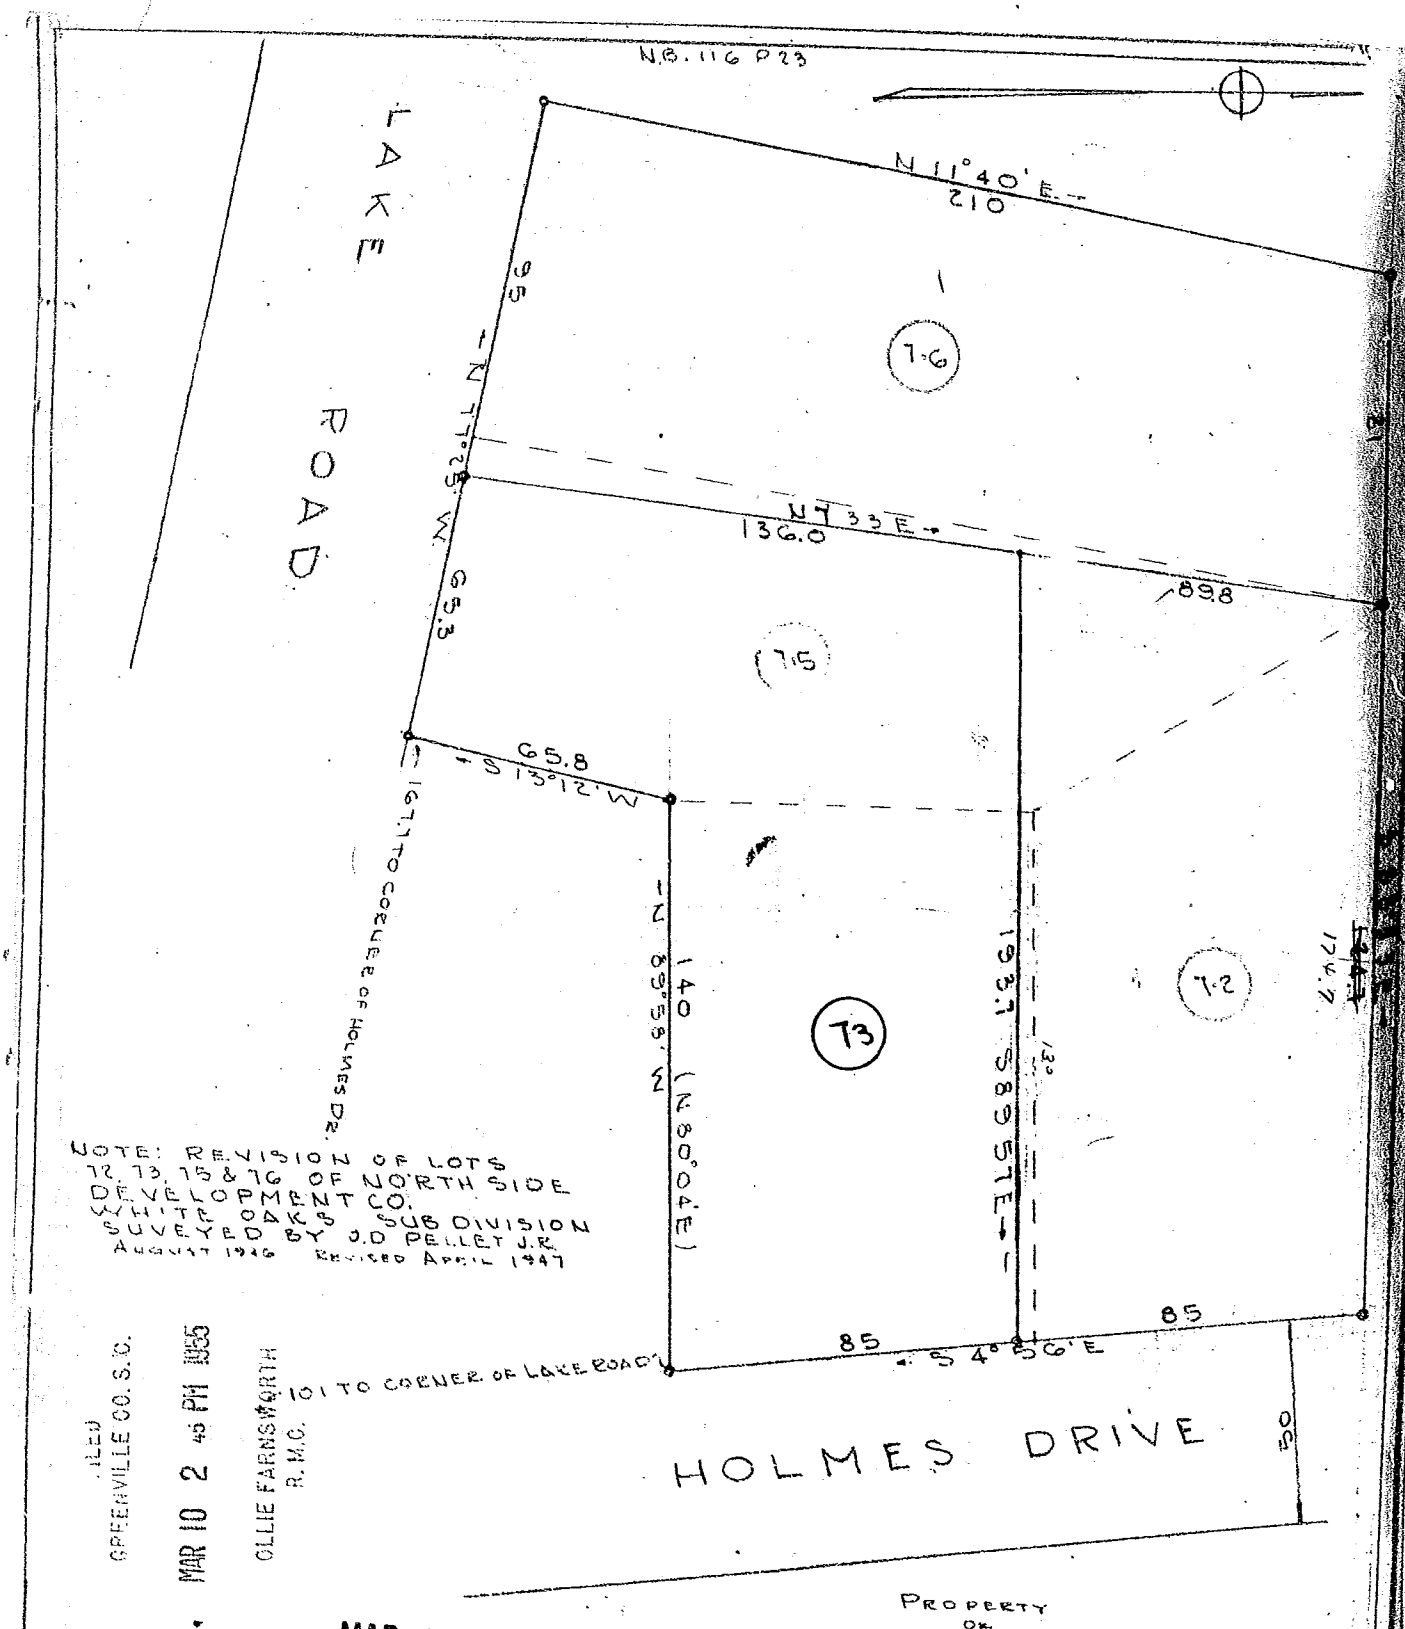


#6280 Filed This 10 day of March 19 55
And Recorded in Vol. EE Page 95 at
Ollie Farnsworth
Register Mesne Conveyance Greenville County, S.C.

95