

FILED
IN THE PUBLIC OFFICE

OCT 29 11 10 AM 1956


THE FAARH
S. W.

OCT 29 1956 27137

PEACHTREE TERRACE

PROPERTY OF
E. M. BISHOP
MAULDIN S. C.
Scale 1"=100' Jan. 1956

DALTON & NEVES

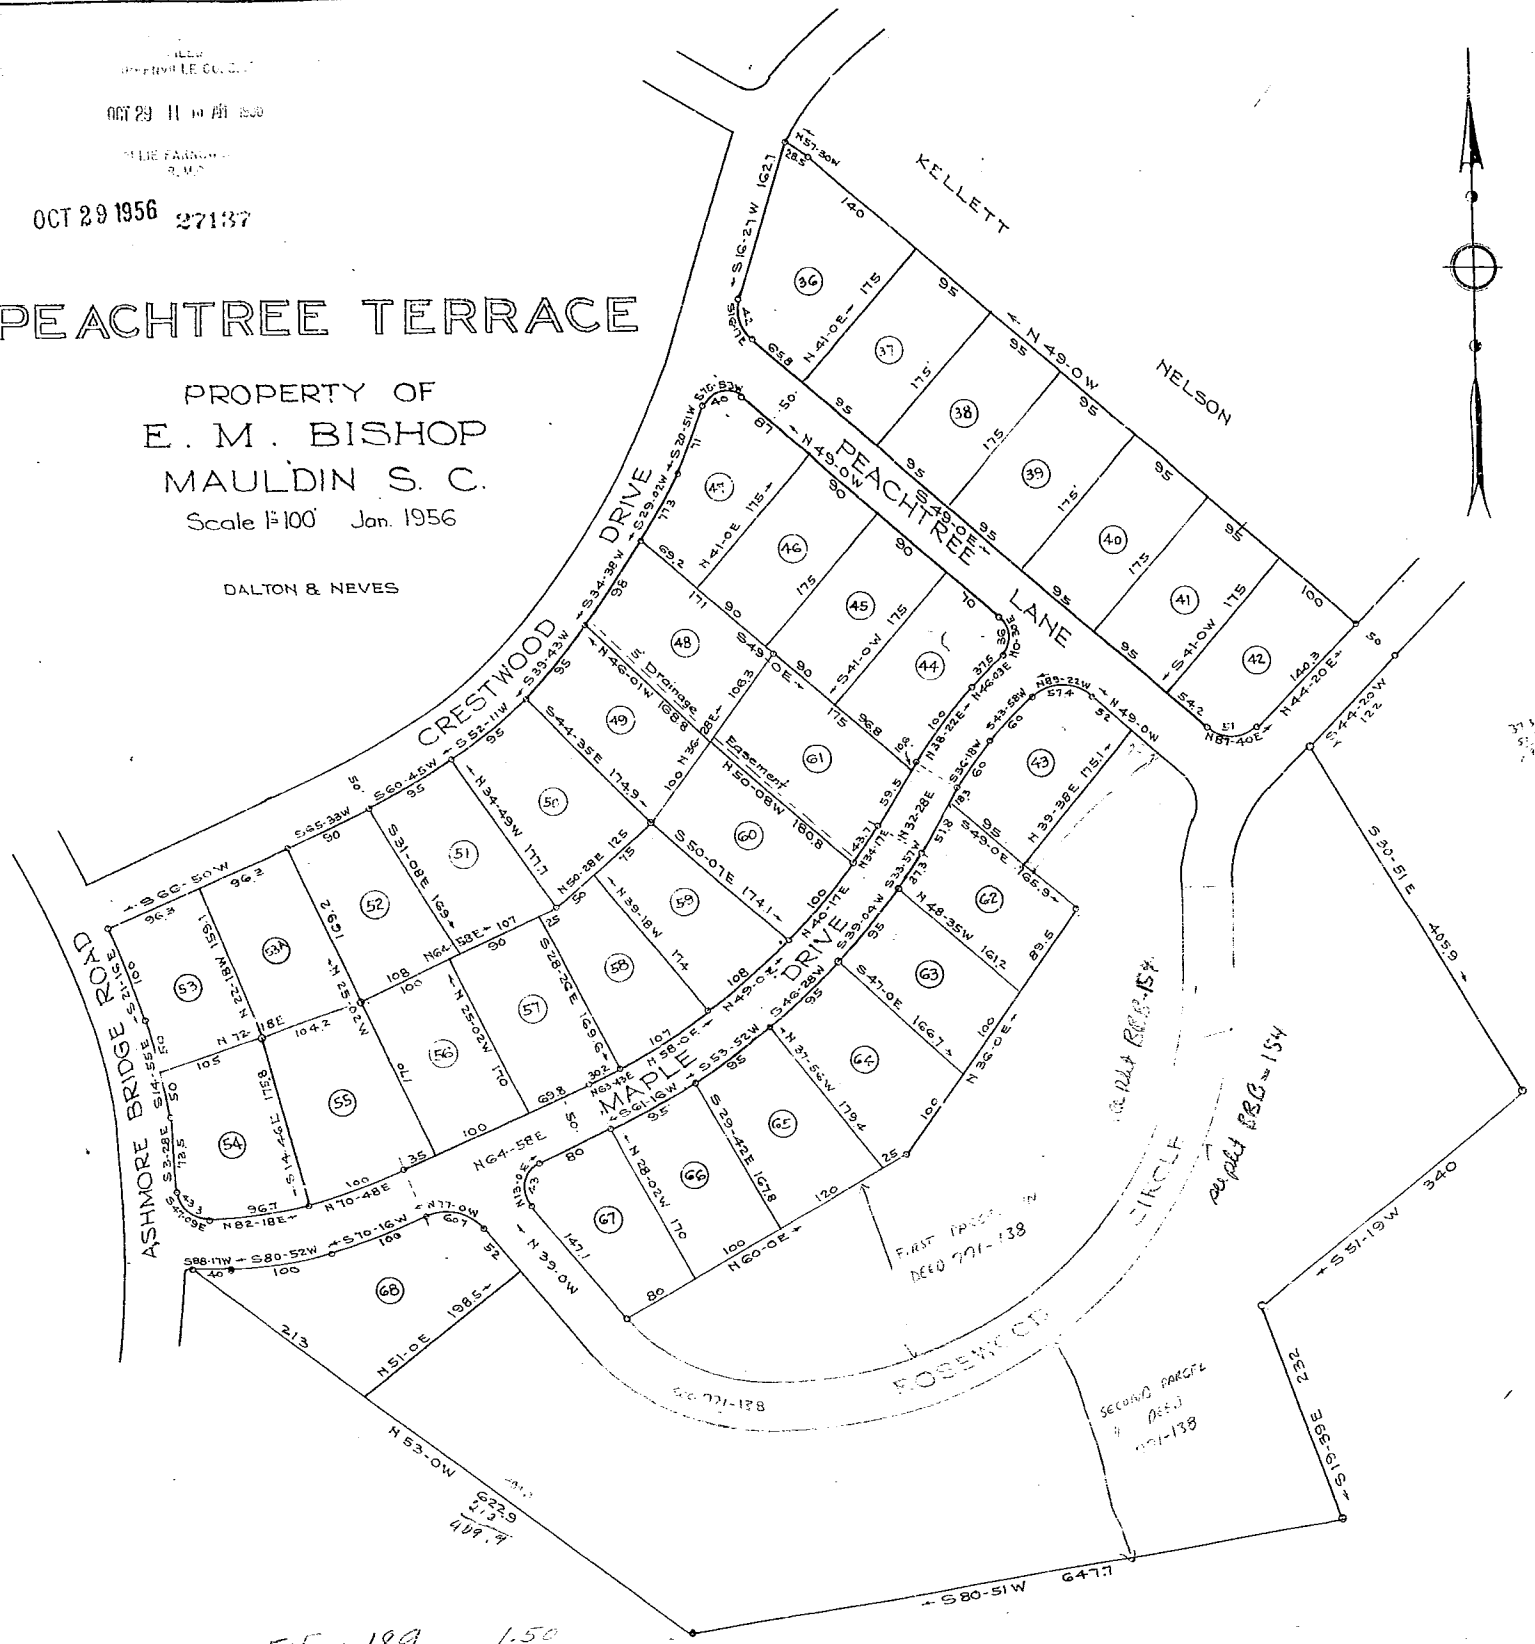

EE-189 1.50

Revision Lots 53A thru 55 made Sept. 1956
iron Pins at all Corners

Book

27137...
and Recorded in...
Celia...
Register...
S. C.