


6716

MAR 25 1953

RECORDED
GREENVILLE CO. S. C.
MAR 25 10 44 AM 1953
BLAKE FARNSWORTH
R.M.C.

PROPERTY OF
TEXTILE REAL ESTATE CO.
GREENVILLE S. C.
SCALE 1" = 30'
MAY 1951

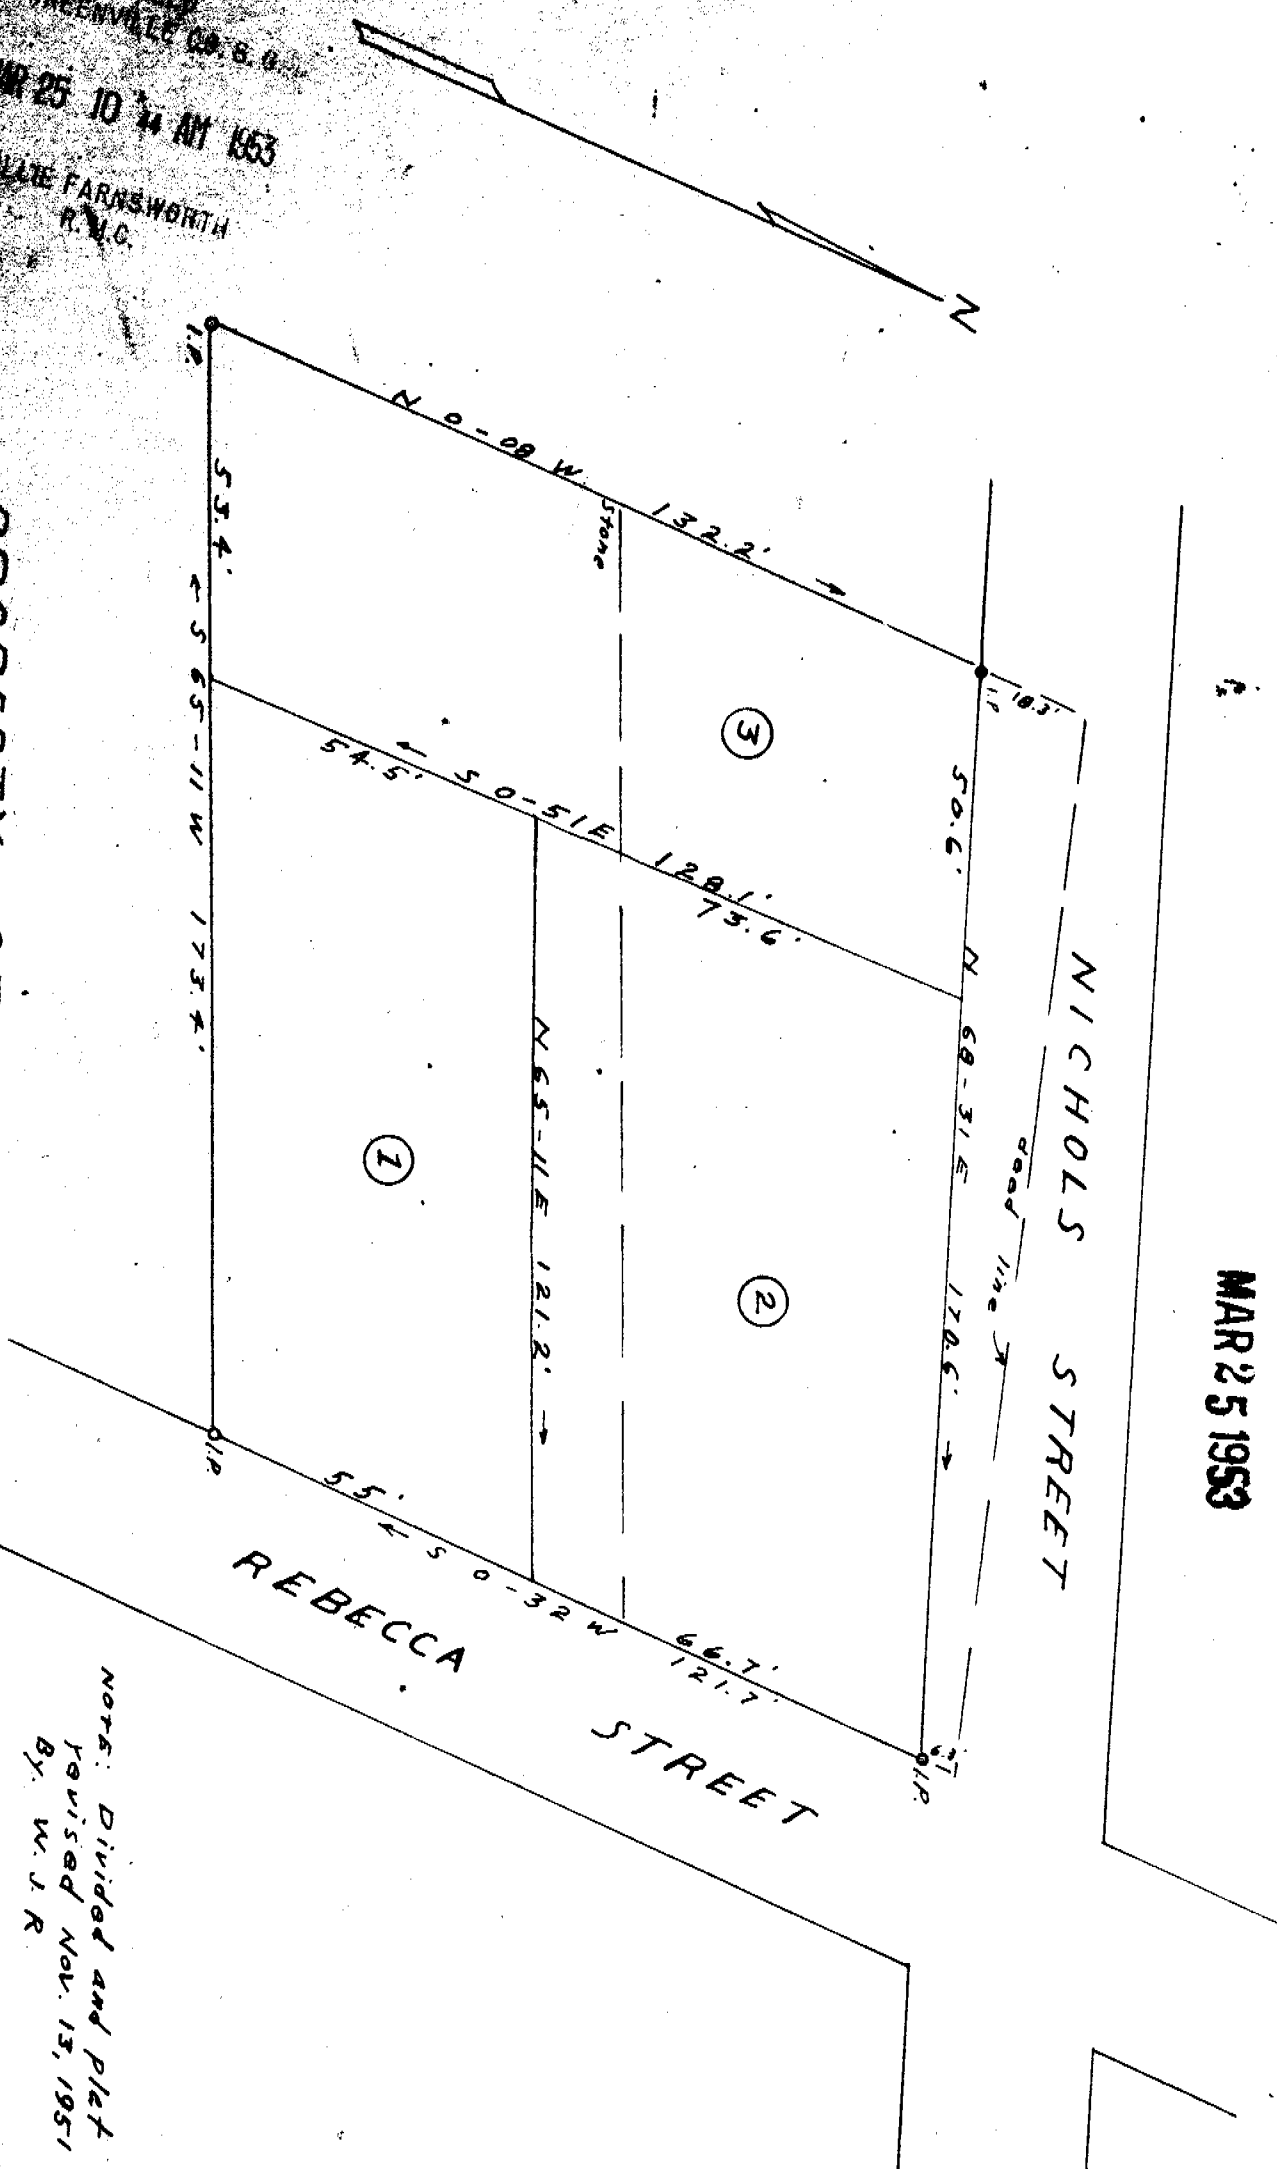

NOTE: Divided and Plat
Revised Nov. 13, 1951
By: W. J. R.

FINAL PLAN APPROVED
GREENVILLE CITY PLANNING & ZONING COMMISSION
DATE March 25, 1953 BY Charles M. Ford
SECRETARY OF COMMISSION

Recorded March 25th. 1953 at 10:44 A. M. #6716