


White line

Terminal Cox  
(with connections)

Correction made before recording  
May 22 1953 H.S.B.

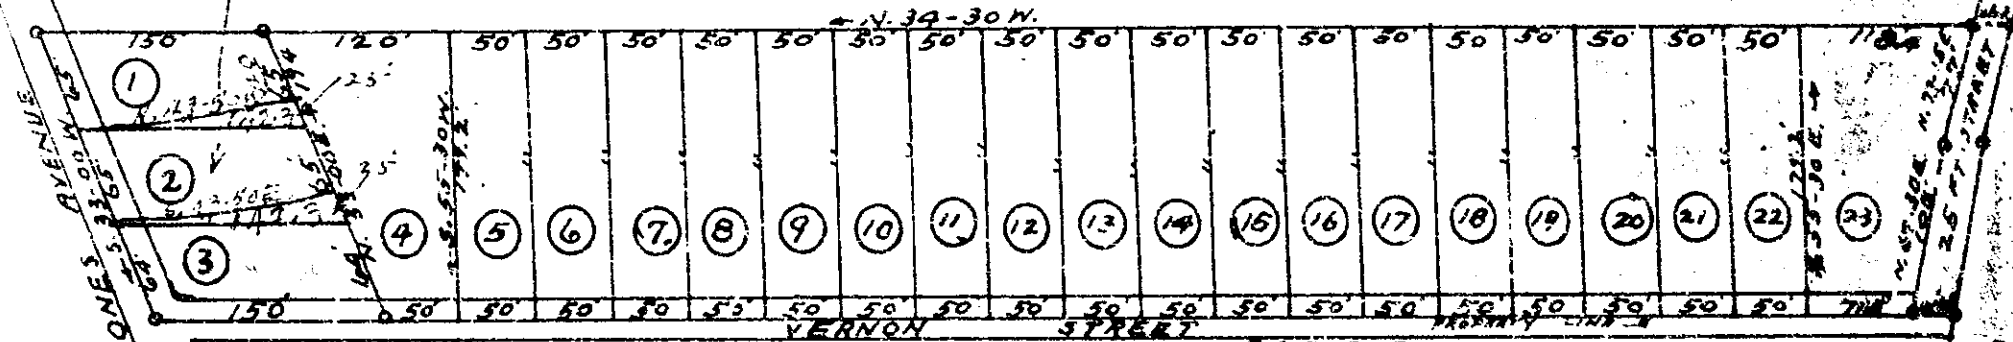

M. H. JONES ESTATE.

PROPERTY OF  
V. E. COX.

LOCATED ABOUT ONE MILE SOUTHWEST FROM GREER  
CHICK SPRINGS TOWNSHIP GREENVILLE COUNTY.

SOUTH CAROLINA.

SCALE: 1" = 100 FEET MARCH 22 1950.

SURVEYED MAY 15 1946

H. S. BROCKMAN, REG SURVEYOR.  
GREER, S. C. - NO. 959

MAY 22 1953

11672

FOR REFERENCE SEE DEED - 221 - 218

Recorded: May 22nd. 1953 at  
4:00 P. M. #11672