JUL 10 11 20 AM 1953

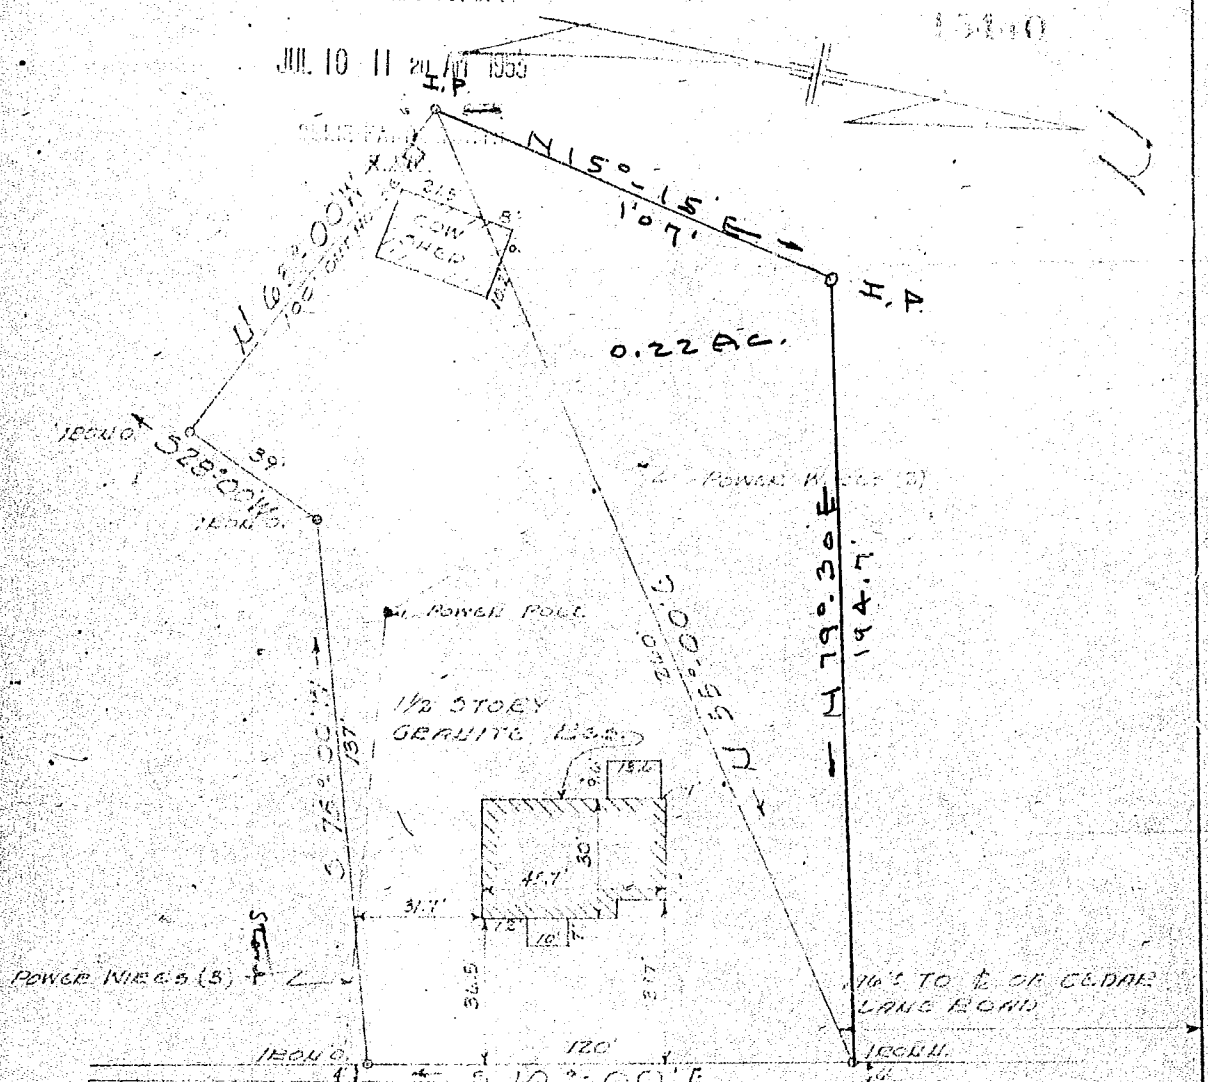

PROPERTY OF:
M. H. NEWTON

LOCATED IN "REGA DISTRICT" NEAR THE
CITY OF GREENVILLE, S.C.

PICKELL & PICKELL, ENGRS.
GREENVILLE, S.C.

SCALE: 1"= 40' DATED: FEB. 7, 1947

I HEREBY CERTIFY THAT THE MEASUREMENTS AS SHOWN ON THIS PLAT ARE CORRECT AND THERE ARE NO PROJECTIONS OR ENCROACHMENTS OTHER THAN SHOWN

Walter J. Pickell Jr., REG. ENGR.

Revised - 5-8-53 - J.C. Hill - L.S. 805

Recorded July 10th. 1953 at 11:20 A. M. #15440