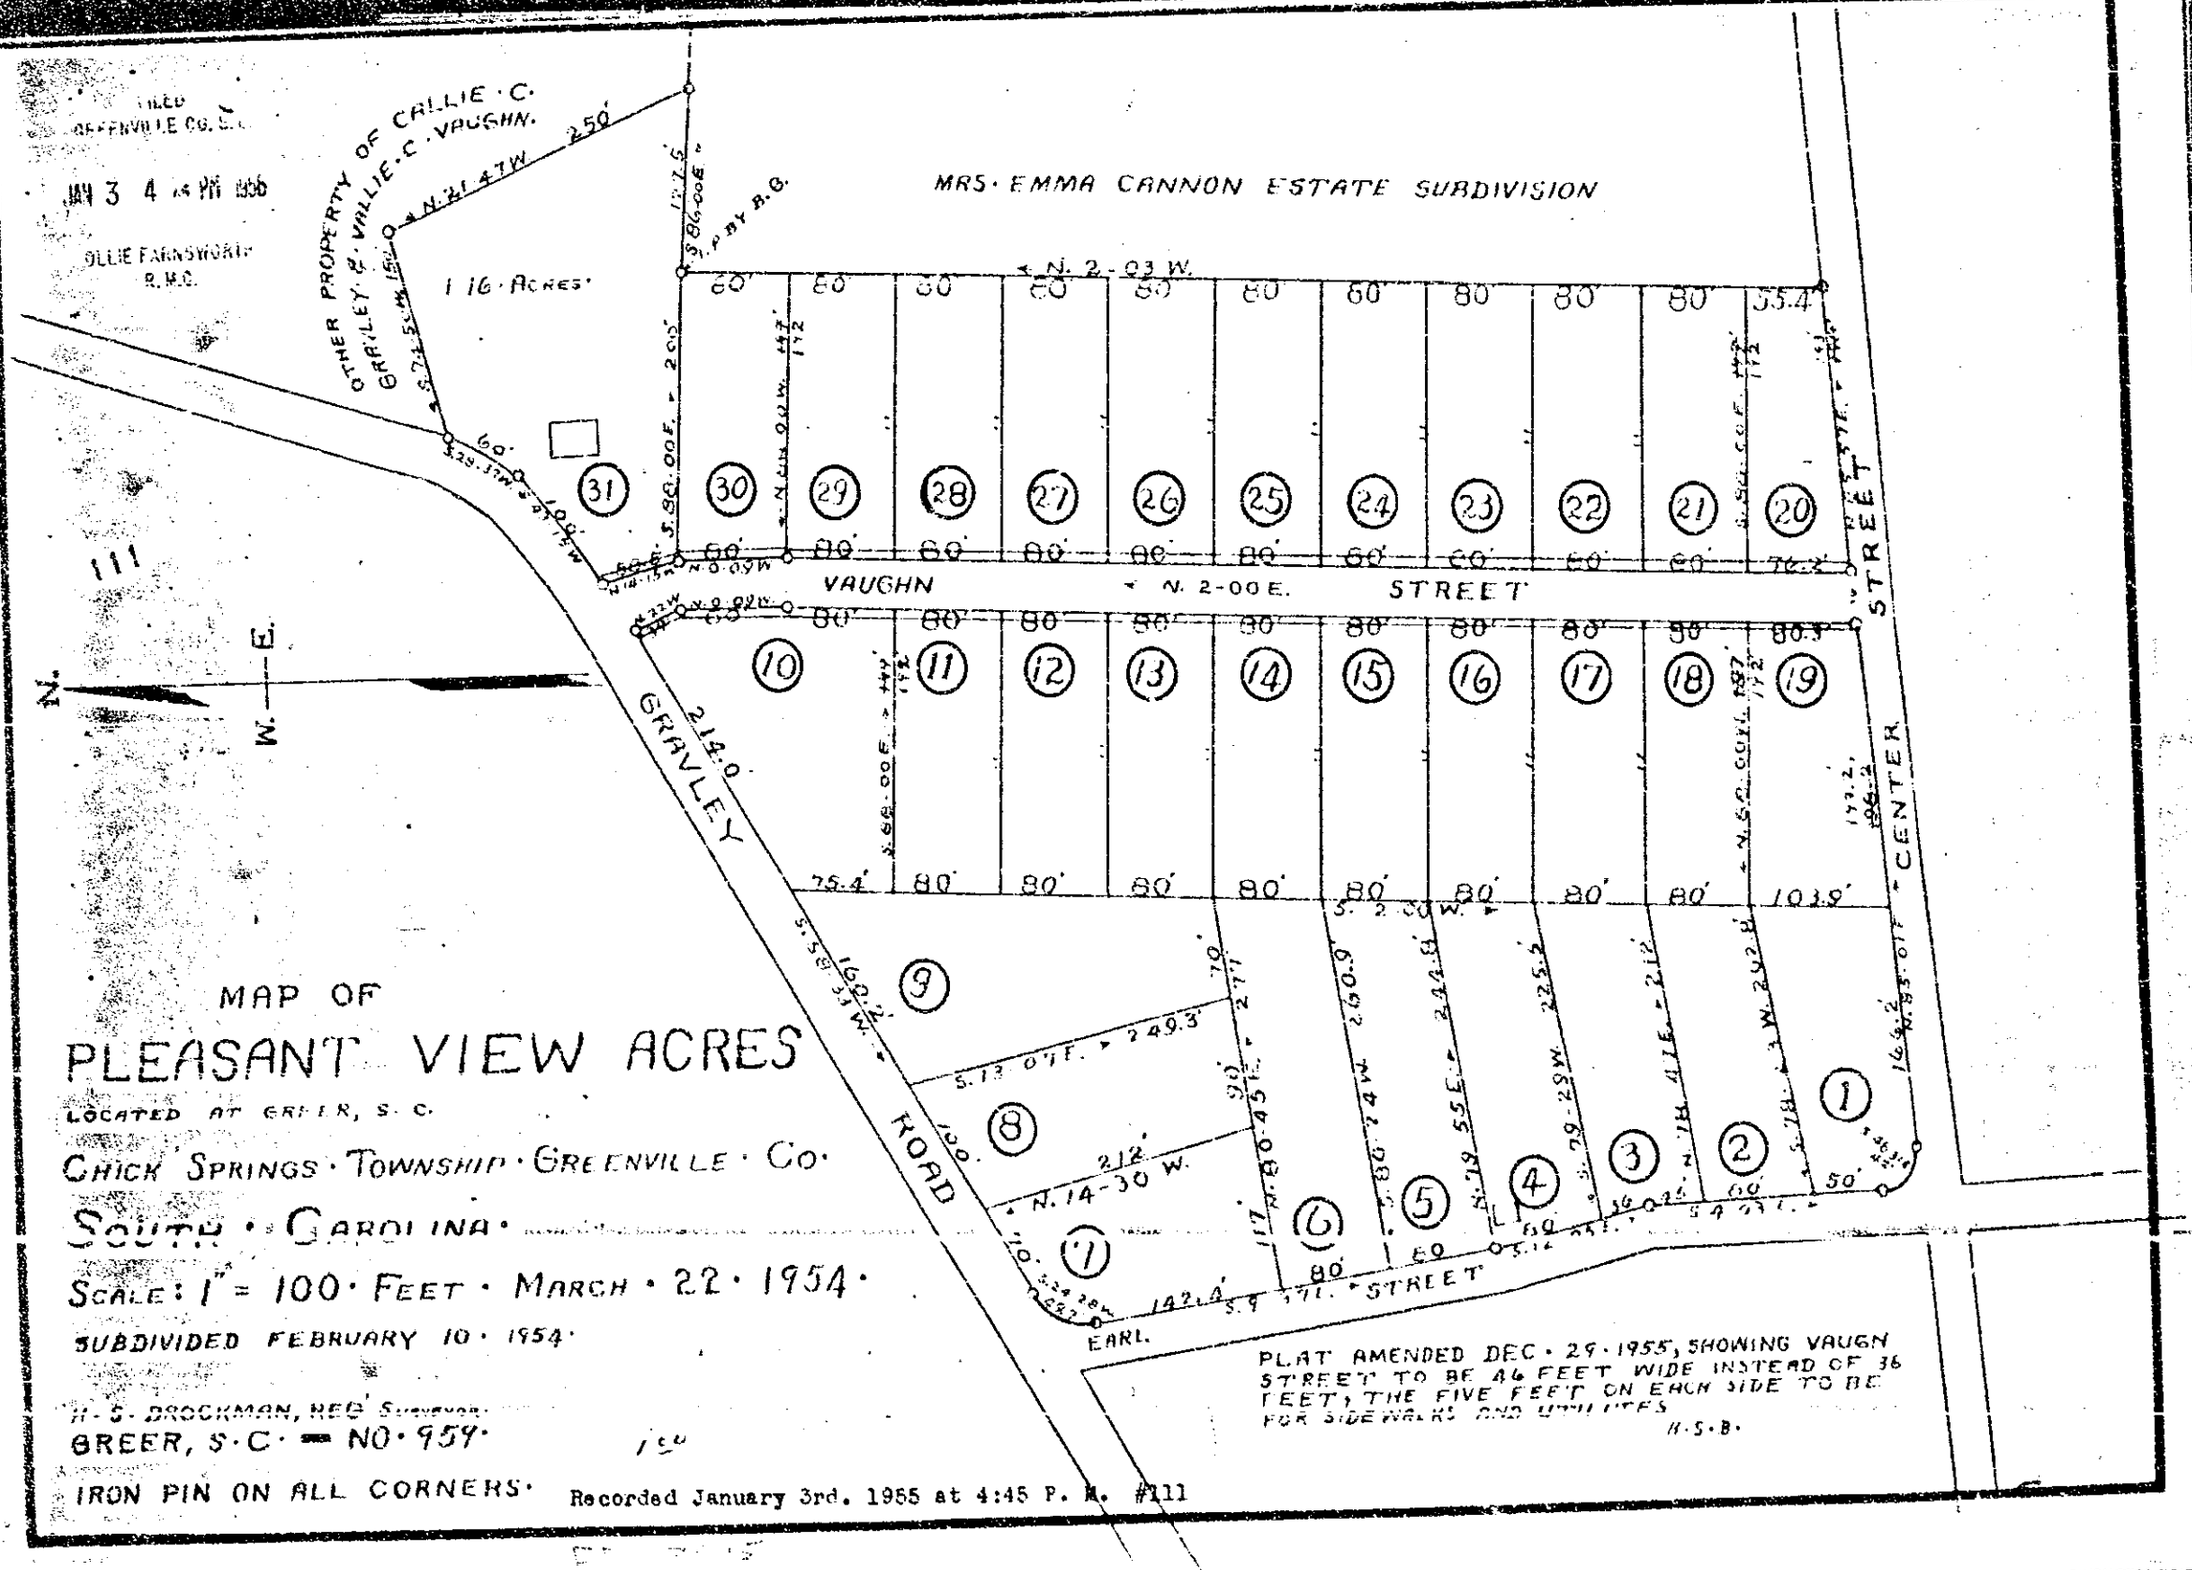

Recorded January 3rd. 1955 at 4:45 P. M. #111