
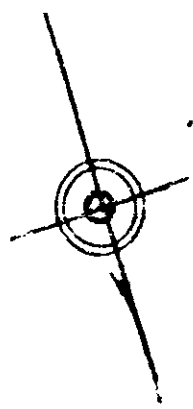


ARLINGTON AVE

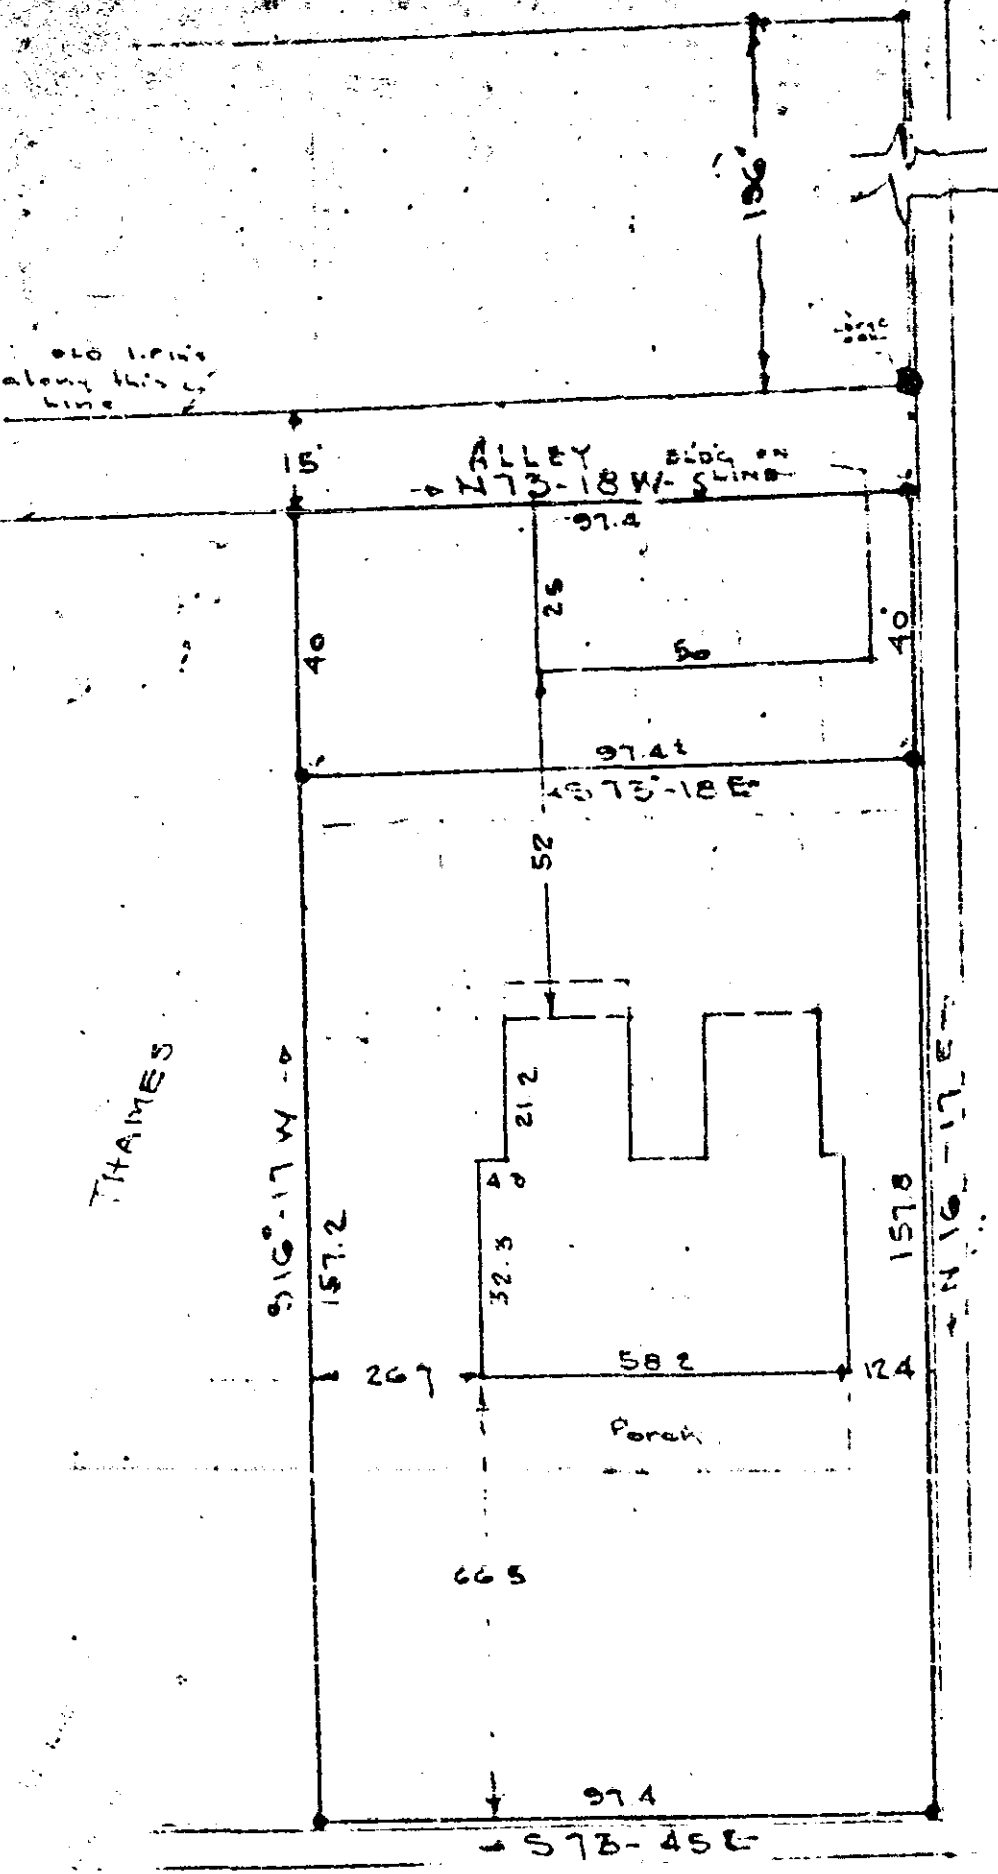

SOUTH CALHOUN ST.

Property of
J.M. BRUCE, TRUSTEE
GREENVILLE, SC.

Scale 1"=30' NOV. 1-1956

PENDLETON ST.

100

77-486

25024

C. C. JONES & ASSOCIATES
ENGINEERS
GREENVILLE, S.C.