


Plat Book HH, Page 3B

REF: PLAT OF VISTA HILLS
FILED IN PLBK. "P" PAGE 149.

FEB 18 2 40 PM '54

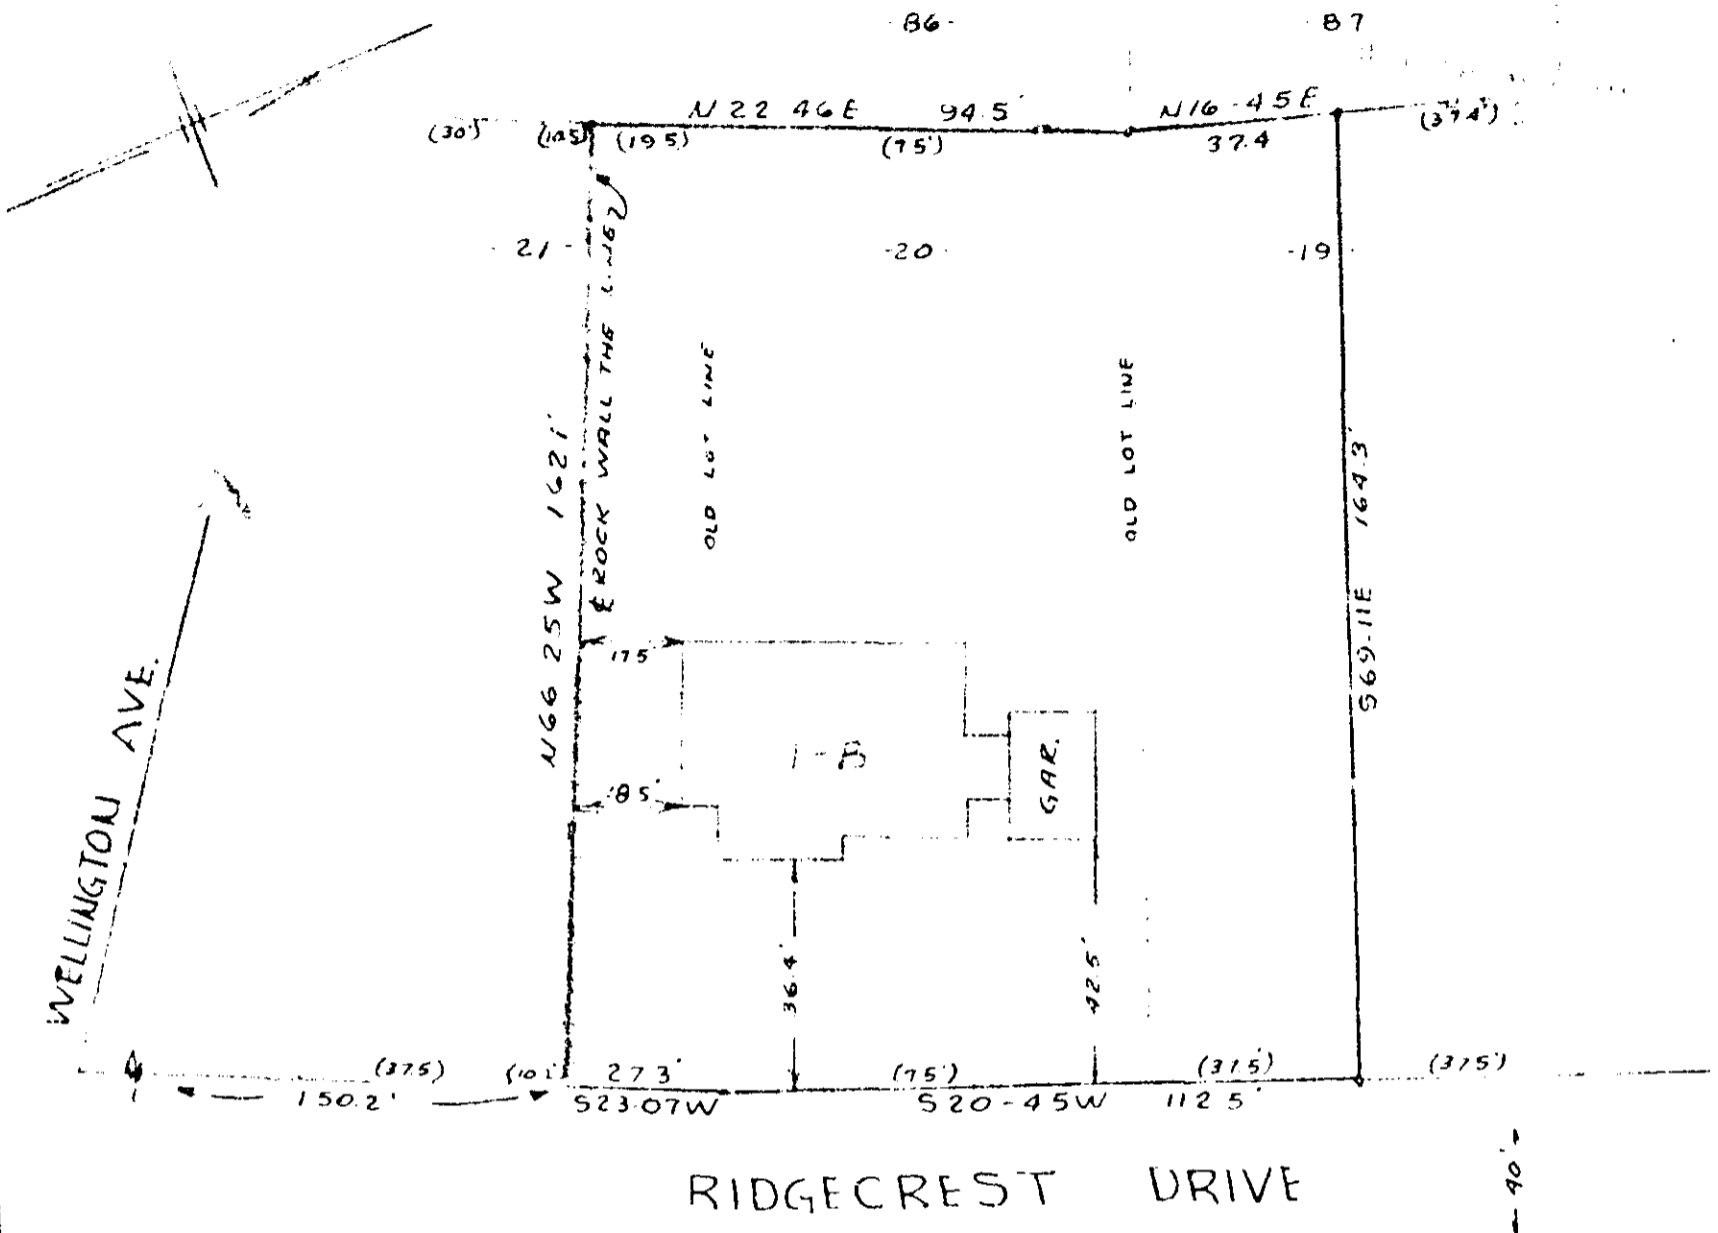

PROPERTY OF
CARL T. SULLIVAN
 GREENVILLE, S.C.
 SCALE 1" = 40 FT. 17 FEB 1954.

FEB 19 1954

This is to certify that on the 17th day of Feb., 1954, I surveyed the property on the above plat, and that the property lines, walls and buildings are as shown hereon; that the buildings located on said lot do not encroach or project on adjacent streets or property; and that no adjacent buildings encroach or project on said premises.

Douglas S. Peach
 Reg. Engr. No. 962



PIEDMONT ENGINEERING SERVICE
 GREENVILLE, S. C.

3787 Filed Feb 18 day of Feb 1954
 and recorded in Vol. 496 Page 3 of 18
Ellis Samworth
 Register of Deeds Greenville County, S. C.