


EAST MOUNTAIN VIEW AVE.

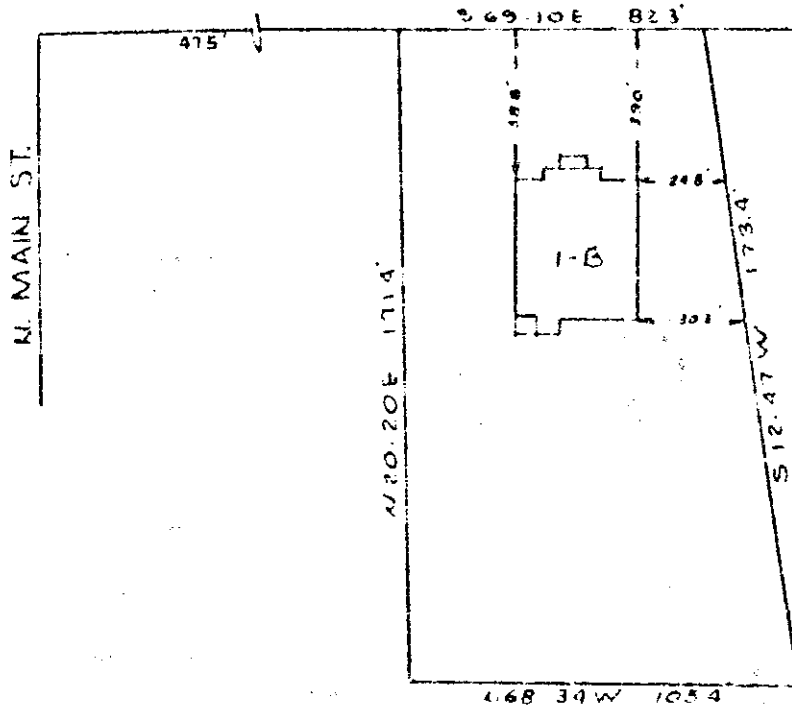

PROPERTY OF
 SOL S. SHIMLOCK
 &
 BARBARA IRENE G. SHIMLOCK
 GREENVILLE, S C

Scale 1 in = 50 ft

27 Dec 1954

This is to certify that on the 27th day of December, 1954, I surveyed the property shown on this plat; and that the property lines, walls and buildings are as shown hereon; that the buildings located on said lot do not encroach or project on adjacent streets or property; and that no adjacent building or walls encroach or project on said property.

FILED
 GREENVILLE CO.
 DEC 30 3 38 PM '54
 OLLIE FARNSWORTH
 R.M.C.

29861

DEC 30 1954

[Signature]
 Reg. Engineer No. 962



PIEDMONT ENGINEERING SERVICE
 GREENVILLE S C

#29861 Filed This 30 day of Dec 1954
 and Recorded in Vol II Page 11
 Ollie Farnsworth
 Register Public Conveyance Greenville County, S. C.

[Handwritten notes and signatures]