


Plat Book-II-Page 178

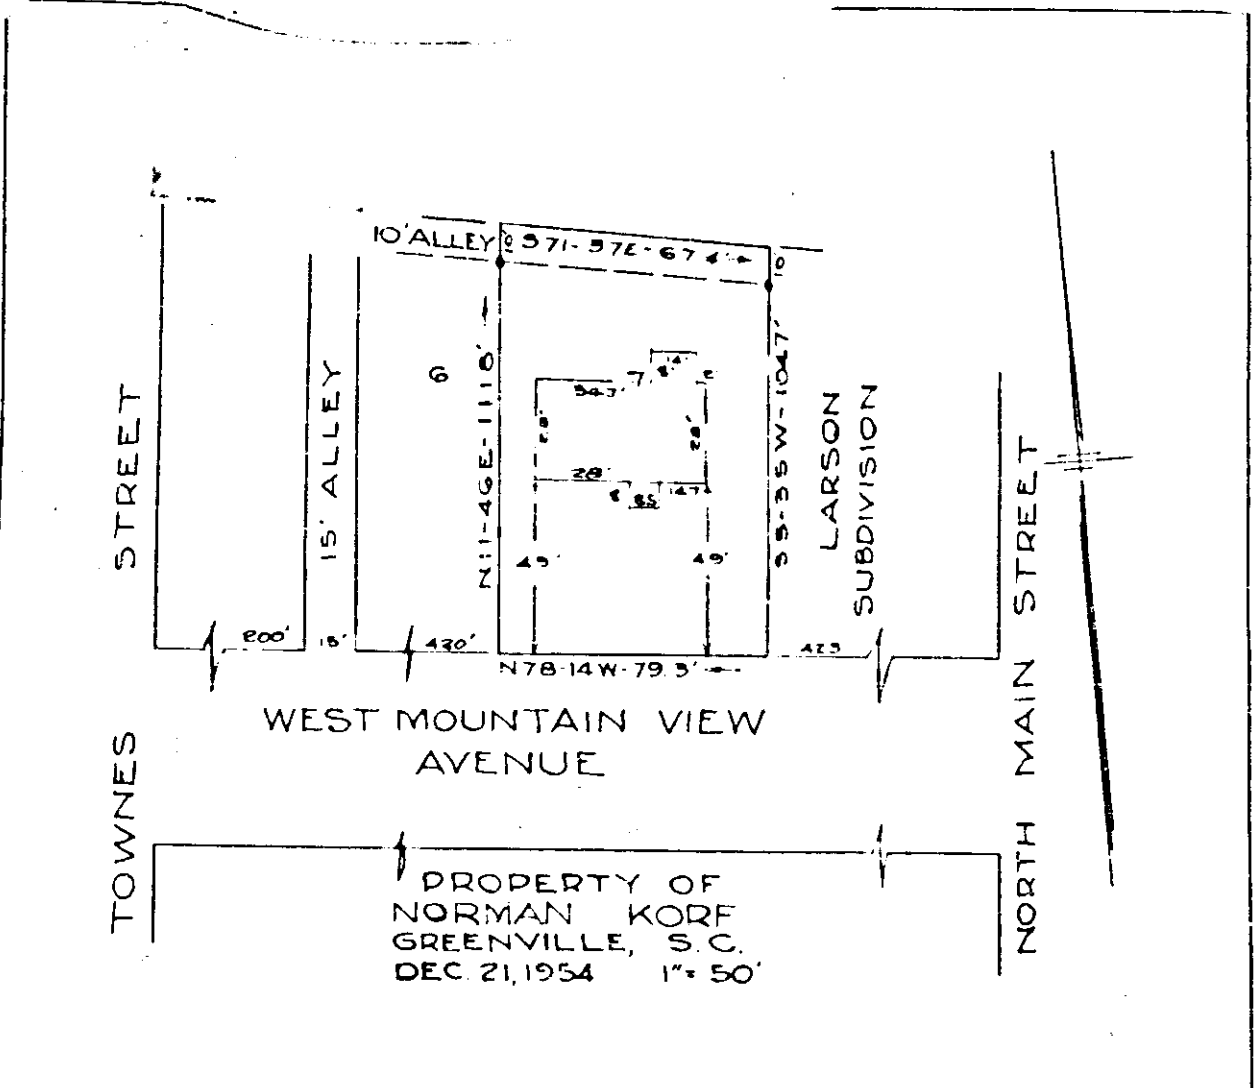

PROPERTY OF
 NORMAN KORF
 GREENVILLE, S.C.
 DEC. 21, 1954 1" = 50'

This is to certify that on the 21st day of December 1954, I surveyed the property shown on this plat being lot number 7 on plat of J. W. Cannon Property, by Dalton and Neves, dated June 1950, and recorded in Plat Book "T" at page 289. Office of R. M. C. for Greenville County, South Carolina, and that the property lines, walls and buildings are as shown hereon; and that the walls and buildings located on said lot do not encroach or project on adjacent streets or property; and that no adjacent buildings or walls project or encroach on said premises.

J. C. Adams
 J. C. Adams,
 Reg. Engineer # 307.

JAN 6 - 1955
 479

T. C. ADAMS C.E.
 GREENVILLE, S.C.

20-17

479 - Filed This 6 day of Jan 19 55
 And Recorded in Plat II Page 178
Edna Gansworth

GREENVILLE CO. S. C.
 JAN 6 3 51 PM 1955
 OLLIE FARNSWORTH
 R. N. C.