


PROPERTY OF
 GREENVILLE BUILDERS
 SUPPLY COMPANY
 GREENVILLE S. C.
 Scale 1" = 50' Sept 1954

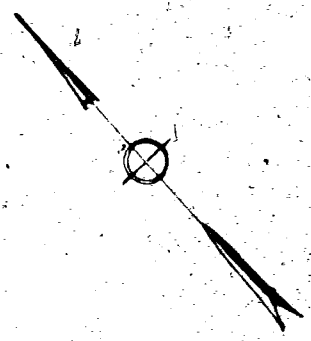

This is to certify that on the 10th day of September, 1954, I surveyed the property shown on this plat; and that the property lines, walls and buildings are as shown hereon; that the buildings located on said lot do not encroach or project on adjacent streets or property; and that no adjacent buildings or wells encroach or project on said premises.

R. W. Dalton
 Registered.

32987 Filed This 23 day of Dec. 1956
 and Recorded in Vol 89 Page 87 at 10:43 A.M.
James H. Lawrence
