Plat Book K-KK-Page 96 B

N.D 133

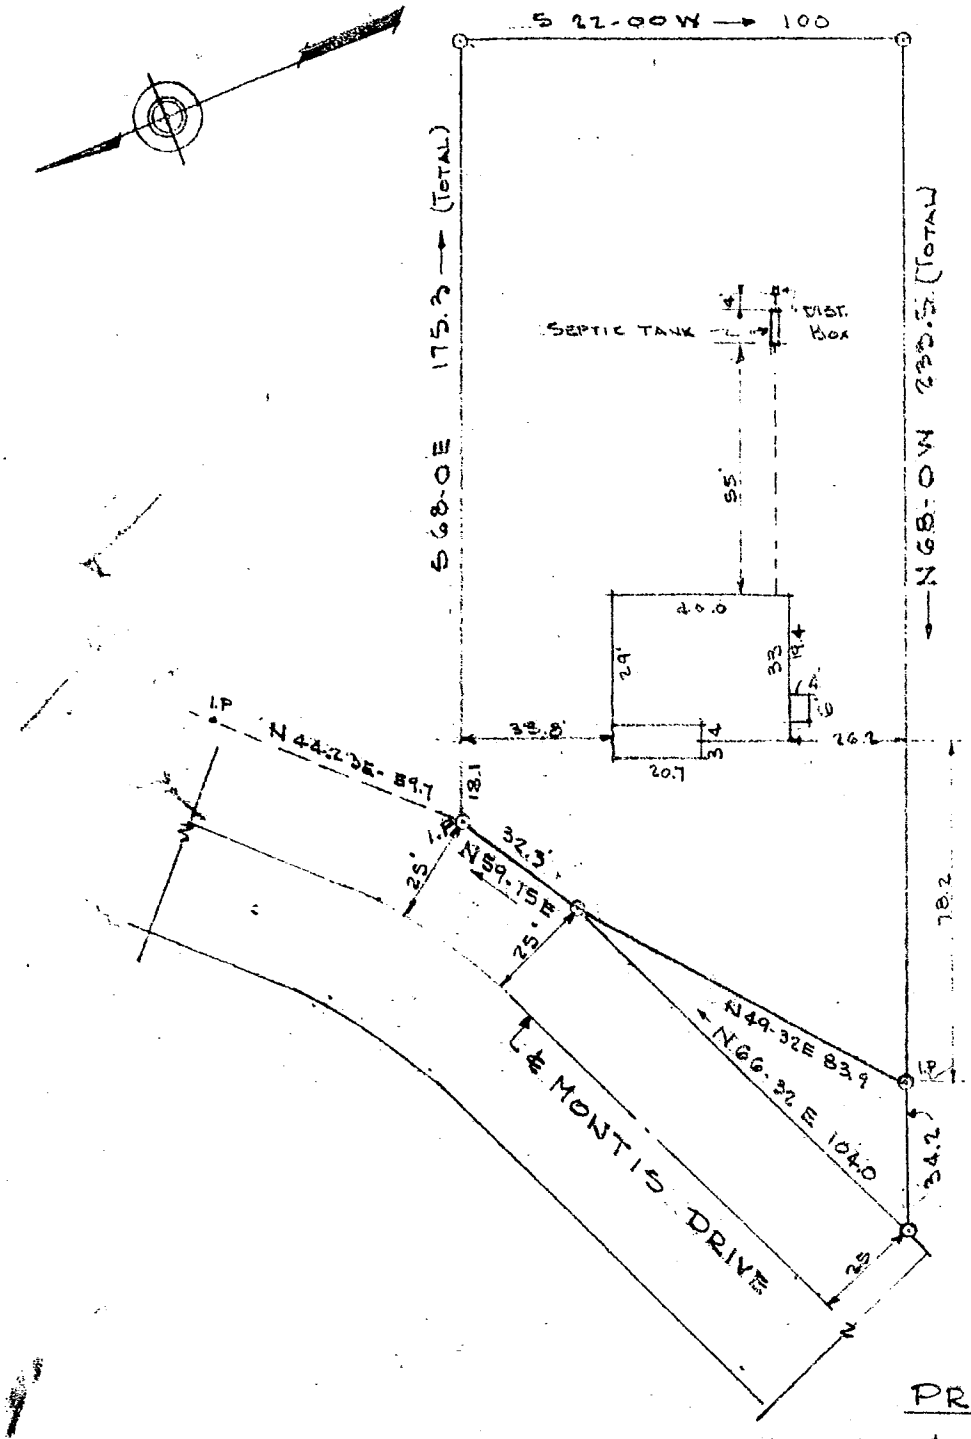

PROPERTY OF
J.B. & WILLIE H. QUINN
NEAR
GREENVILLE, S.C.
SCALE 1"=40'. SEPT. 4. 1958

SEP 6 - 1958

6351 KK-96
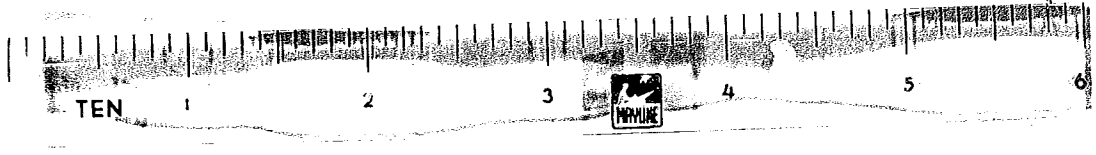
JONES & SUTHERLAND - ENGINEERS
GREENVILLE, SO. CAROLINA.