


POST OAK RD

WILLIS

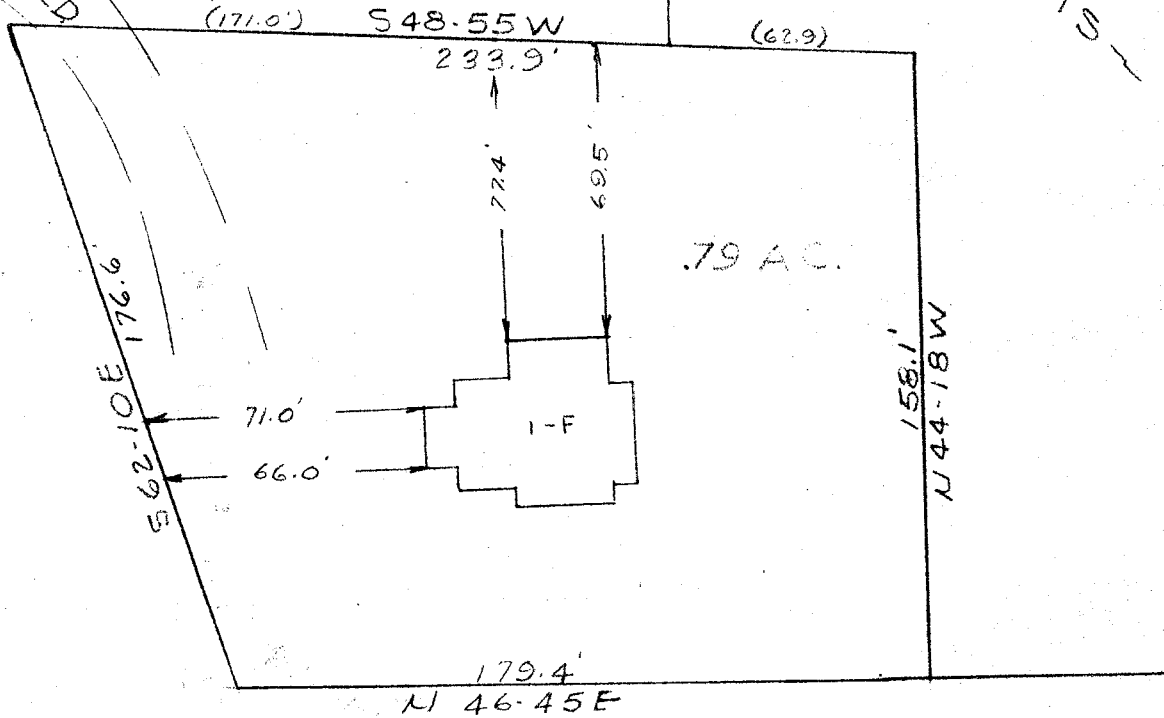

PROPERTY OF
BARTLEY J. DYER
 NEAR GREENVILLE, SC.
 SCALE 1"=40' JUNE 20, 1956

This is to certify that on the 20th day of June, 1956, I surveyed the property shown on this plat; and that the property lines, walls and buildings are as shown hereon; that the buildings located on said lot do not encroach or project on adjacent streets or property; and that no adjacent walls or buildings encroach or project on this lot; and that there are no utility lines crossing this property except as shown.

GREENVILLE CO. S. C.

JUL 9 12 15 PM '56

OLLIE FARNSWORTH
R. M. C.

17348

JUL 9 - 1956

Samuel S. Louch
 Registered Engineer No. 962



PIEDMONT ENGINEERING SERVICE
 GREENVILLE, S. C.

22-13

17348 Filed This 9 day of July 1956
 and Recorded in Vol. 6 Page 13 at
OLLIE FARNSWORTH
 Register Meane Conference Greenville County, S. C.