
Plat Book-KK-Page 1141 B

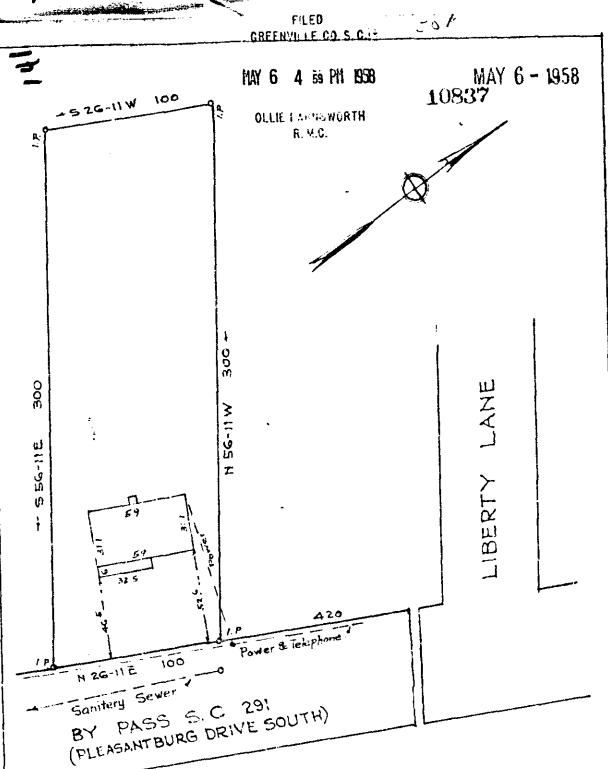

PROPERTY OF

CHARLES C. SWITZER

AND KEK CO. INC.

GREENVILLE S. C.

Scale 1-50' Feb. 1956

This is to certify that on the 6th day of February, 1958, I surveyed the property shown on this plat; being known as part of the McAlister Estate, Recorded in Plat Book GG pages 46-47, Office of R. M. C. Greenville Co., S. C.; and that 'ne property lines, walls and buildings are as shown hereon; that the buildings located on said lot do not encroach or project on adjacent streets or property; and that no adjacent buildings or walls encroach or project on said premises; and that no utility lines cross this property except as shown hereon.

XX-141

h.W. Sullen

3/8