


REF. PLAT OF MCDANIEL  
PROPERTY, FILED  
IN PLBK. E PAGE 218

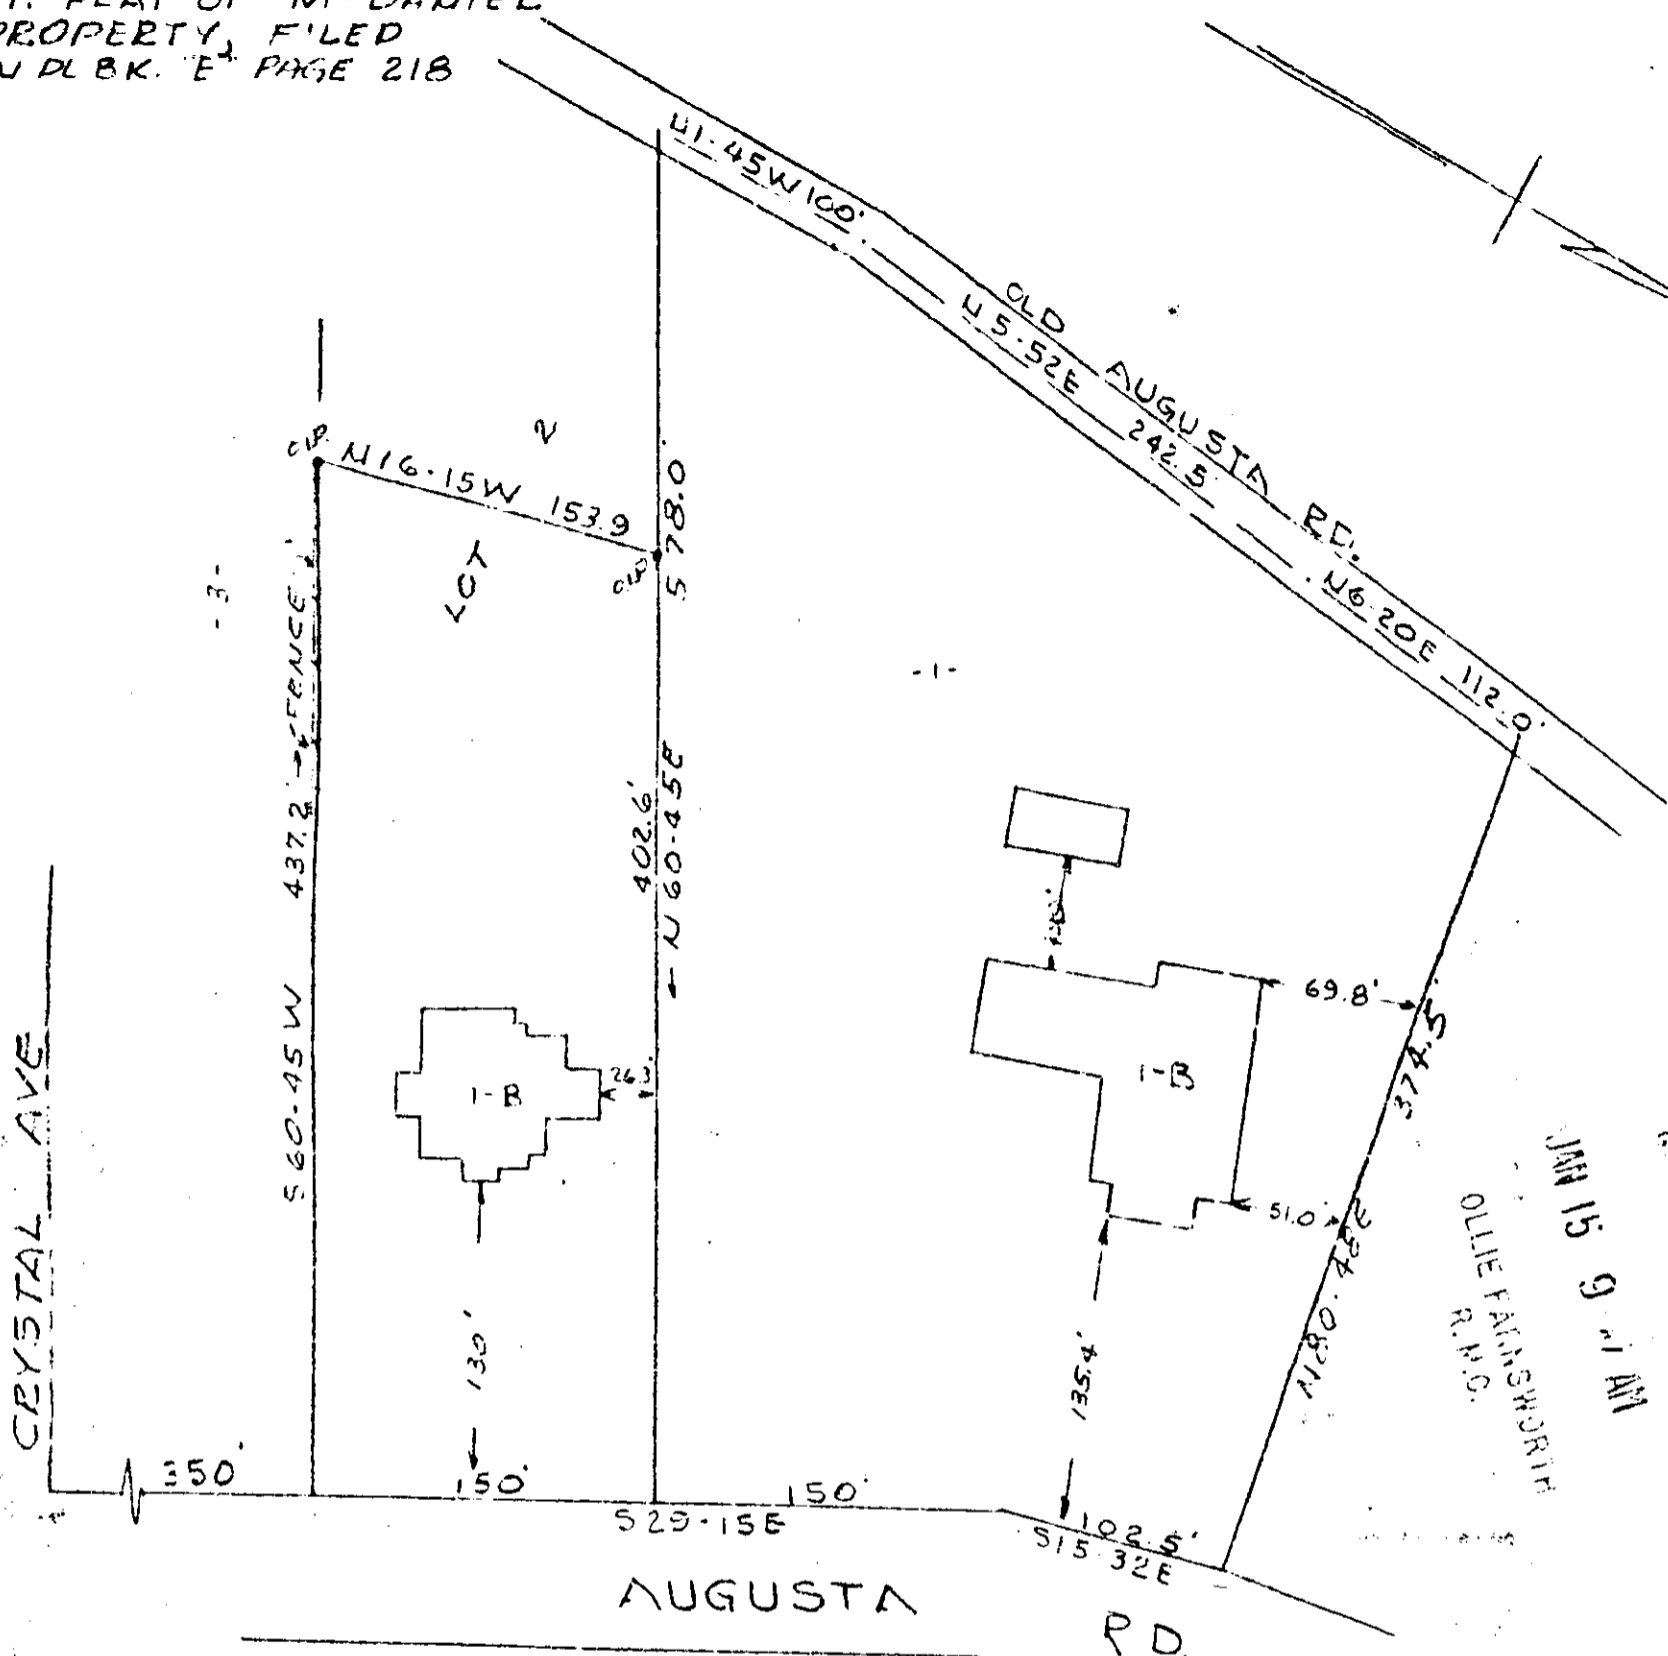

FILED  
GREENVILLE CO. S.C.  
JAN 15 9 11 AM  
R.M.C.

PROPERTY OF  
AUGUSTA HEIGHTS BAPTIST CHURCH  
GREENVILLE S.C.

SCALE 1" = 100 FT.

14 JAN. 1957.

This is to certify that on the 14th day of January, 1957, I surveyed the property shown on this plat; and that the property lines, walls and buildings are as shown hereon; that the buildings located on said lot do not encroach or project on adjacent streets or property, and that no adjacent walls or buildings encroach or project on this lot; and that there are no utility lines crossing this property except as shown.

JAN 15 1957

*[Signature]*  
Registered Engineer No. 962

PIEDMONT ENGINEERING SERVICE  
GREENVILLE, S. C.



1201

175

3272

1201 Filed This 15 day of Jan 1957  
and Recorded in Vol. 88 Page 163  
*[Signature]*  
Register Mesne Conveyance Greenville County, S.C.