


Plat Book-MM-Page 103

37808 Filed This 13 day of May 1959
 And Recorded in Vol. M Page 103 of
 Register of Deeds Greenville County, S. C.

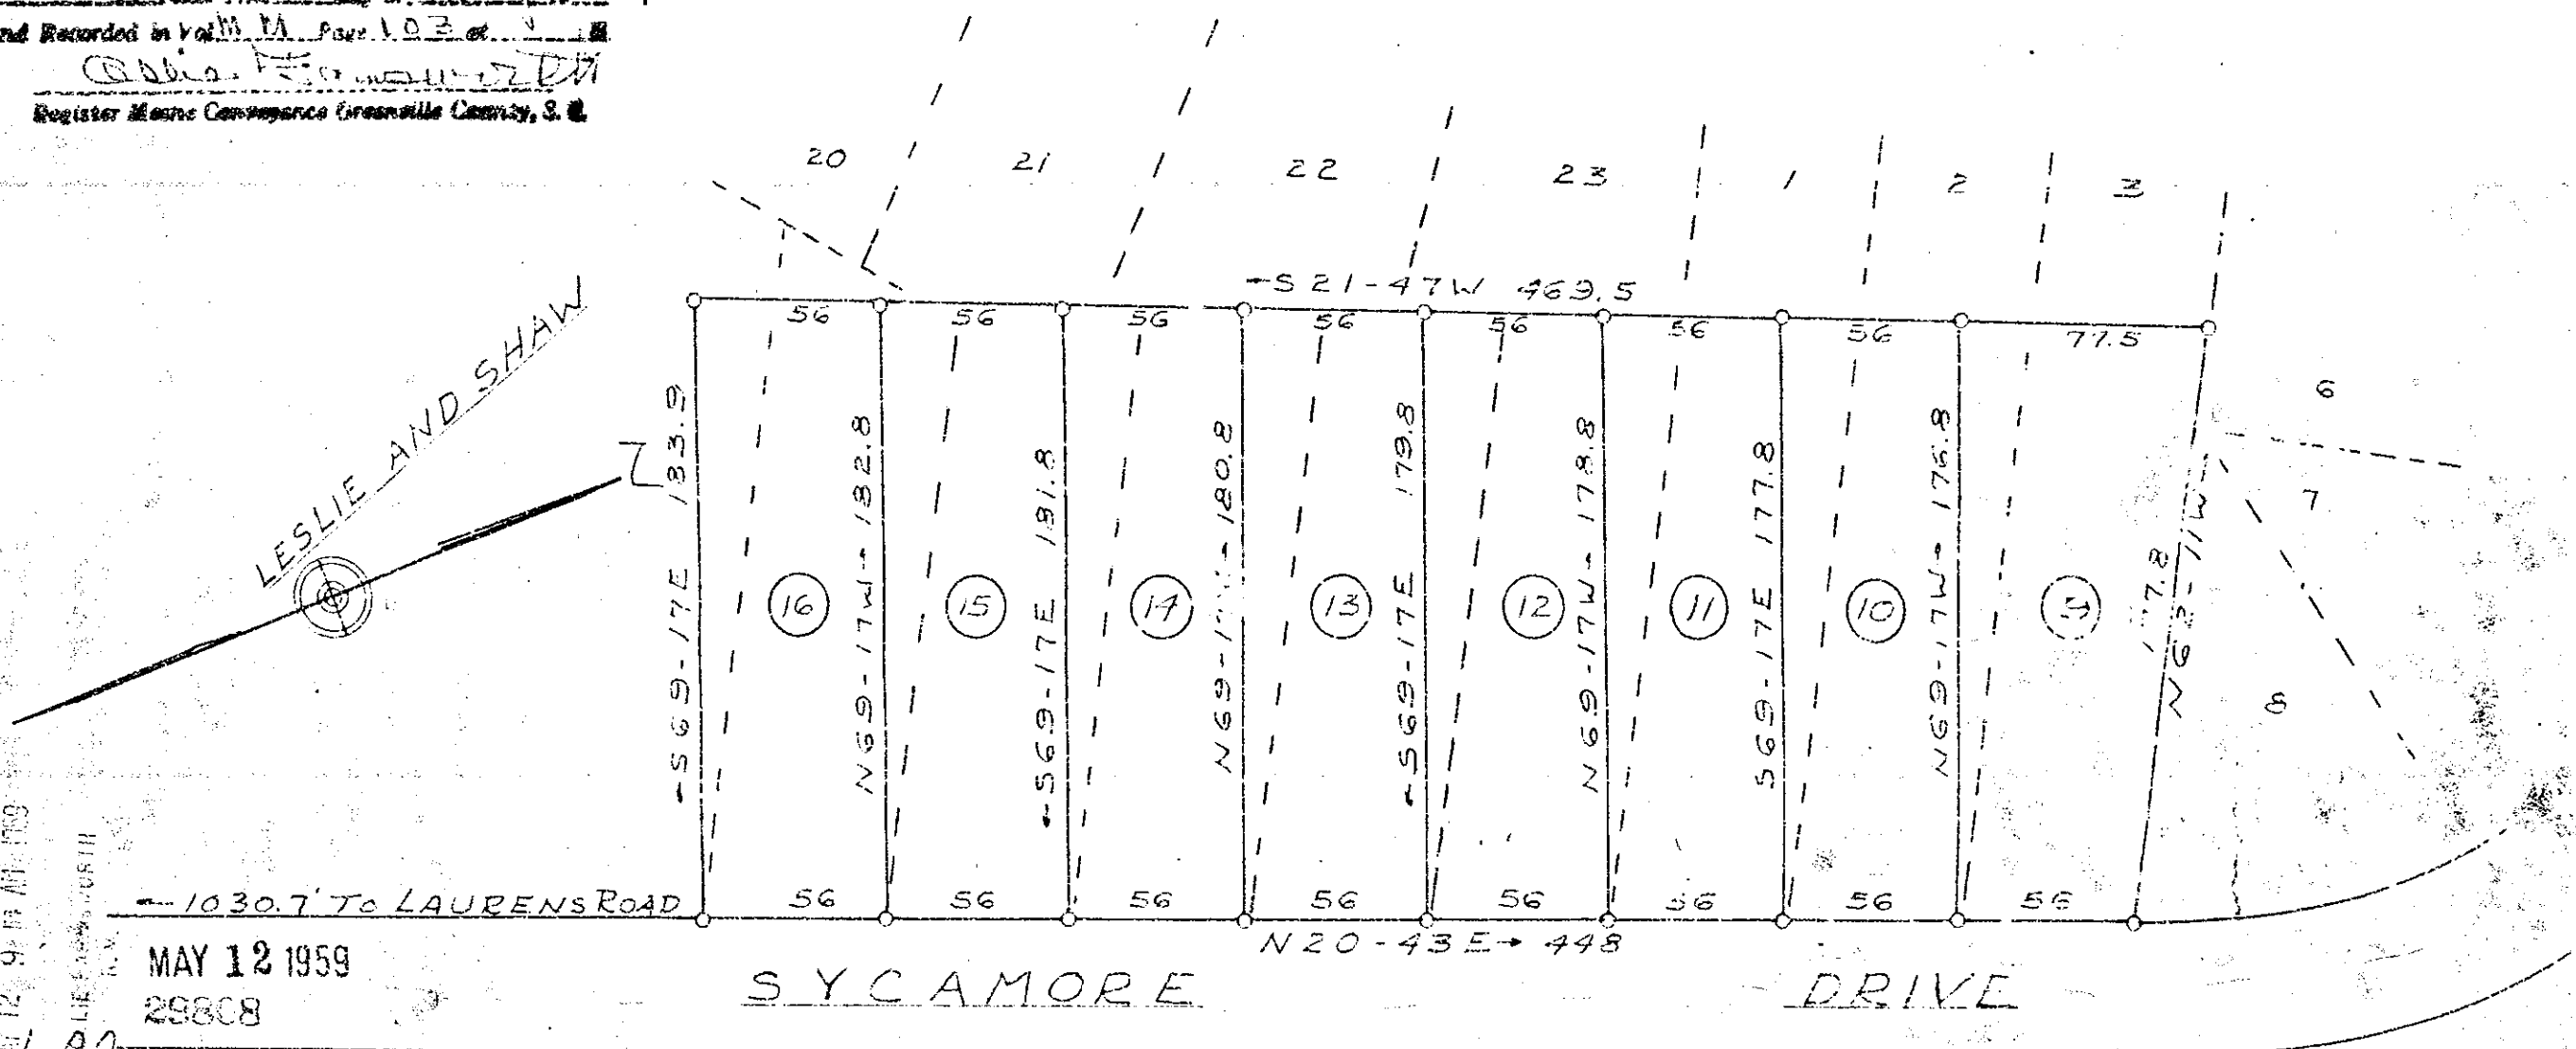

MAY 12 9 13 AM 1959
 LIE S. C. 29808
 MAY 12 1959
 29808

MM-103

I Certify that this is an accurate
 Plat of an actual survey com-
 pleted by me on Jan. 26, 1959
 and that the Street and Lot
 Lines are as shown hereon.

J. Mac Richardson
 R.L.S. No. 598

NOTE: PART OF DAISY T. WILSON PROPERTY
 Recorded in Plat Book O Page 151

BROOKS
 STREET

RESUBDIVISION - LOTS 9 THROUGH 16
 DAISY T. WILSON PROPERTY
 CITY OF GREENVILLE, S. C.
 SCALE: 1" = 50' JAN. 1959
 OWNERS - LESLIE AND SHAW INC.

----- Indicates Original Lot Line
 IRON PINS at all corners

FINAL PLAN APPROVED
 GREENVILLE CITY PLANNING AND ZONING COMMISSION
 [Signature]
 SECRETARY OF COMMISSION