


NOTE: Lots No. 1, 2, & 3
revised April 8 1957

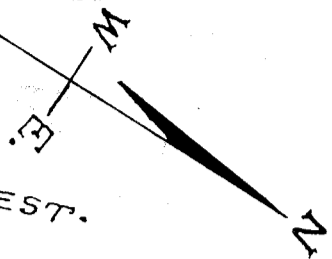

JOHN STEPHENSON EST.
OLD PIN


9178

FILED
GREENVILLE CO. S. C.

APR 17 10 55 AM 1957

OLLIE FAYNSWORTH
R. M. C.

Stephenson Road
N. 120'
68-45 E.
120'

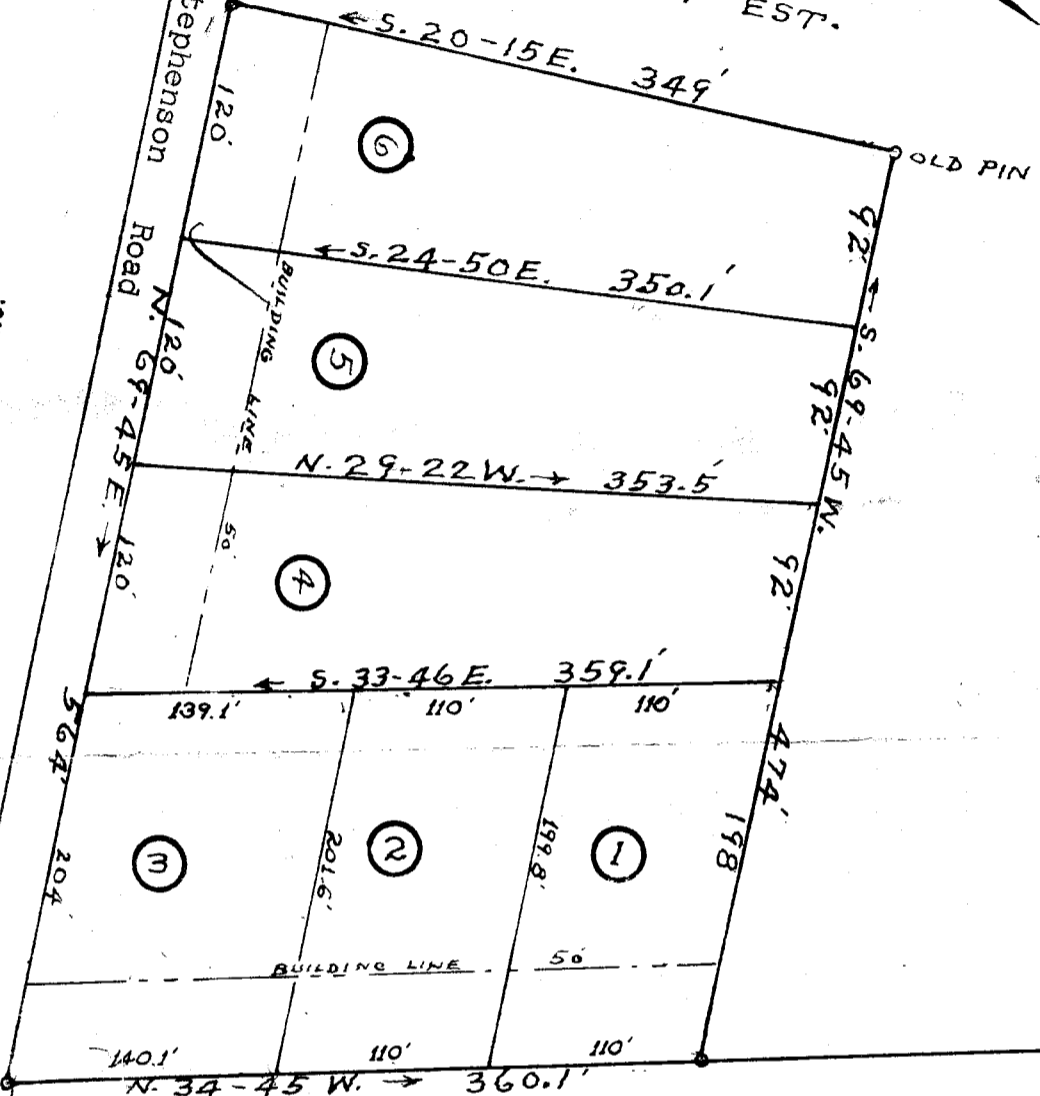

BERRY ROAD

PROPERTY OF JAMES A. SIZEMORE.

LOCATED ONE AND ONE HALF MILES SOUTH OF TAYLORS.
CHICK SPRINGS TOWNSHIP GREENVILLE COUNTY.

SOUTH CAROLINA

SCALE: 1" = 100 FEET. SEPTEMBER 1 1956

SURVEYED AUGUST 6 1956

H. S. BROCKMAN, REG. SURVEYOR.
GREER, S. C. NO. 959

AREA: 4.15 ACRES

Part in 50f

9178 Filed This 17 day of April 1957
and Recorded in Vol. N. N. Page 53 at
Ollie Faysworth
Register Meane Conveyance Greenville County, S. C.

NN 53

53