


Plat Book-N-N-Page 77A

REF: PLAT OF WHITE OAKS SUBDIVISION NORTHSIDE DEVELOPMENT CO.
FILED IN PL. BK. P. PAGE 121.

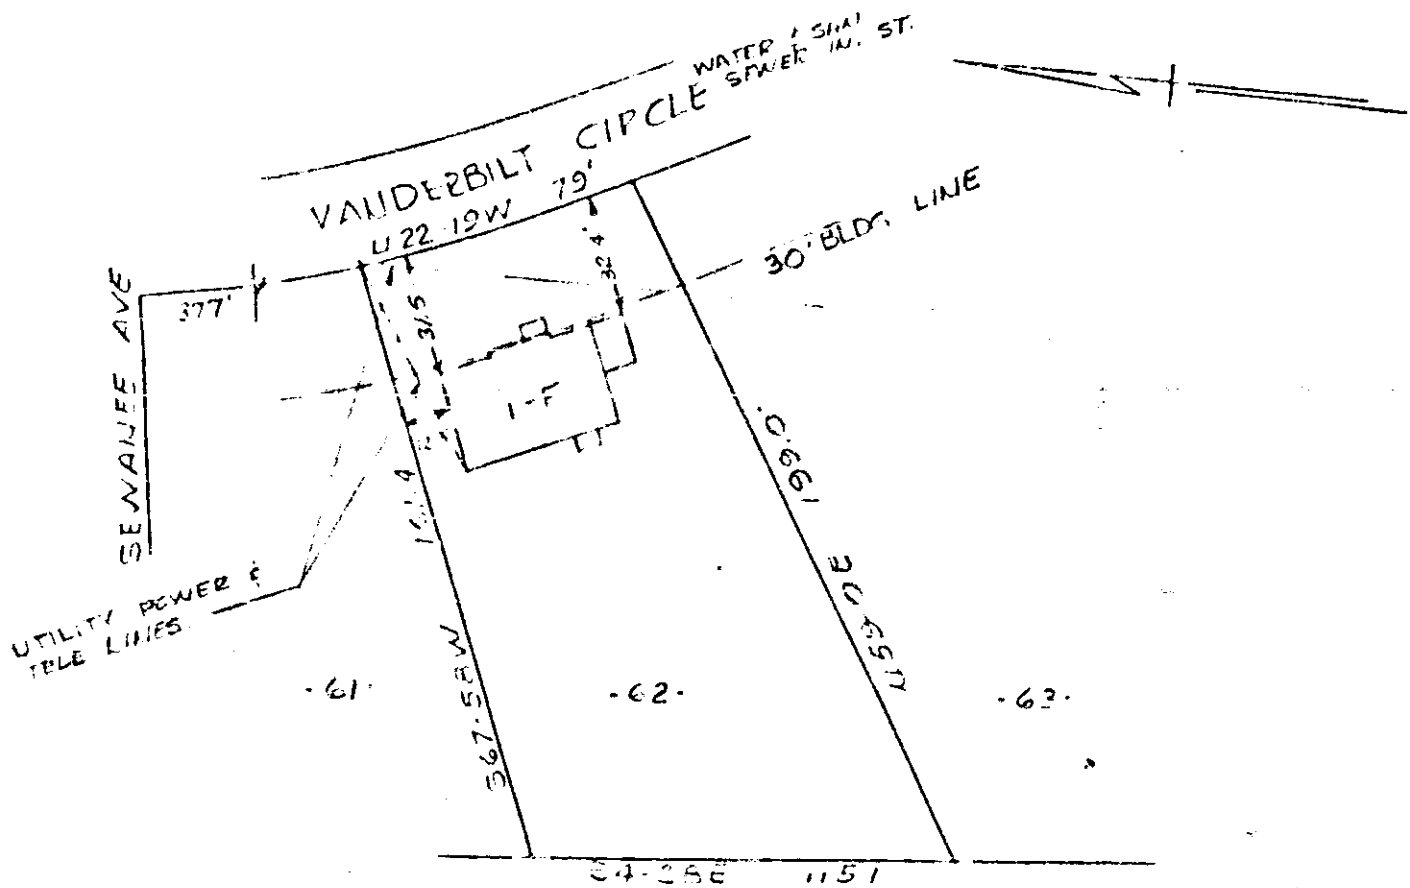

PROPERTY OF
CHARLES DONALD TURNER &
GAIL ALLISON TURNER
GREENVILLE, S.C.
SCALE 1" = 50 FT. 20 MAY 1957

This is to certify that on the 20th of May, I surveyed the property shown on this plat; and that the property lines, walls and buildings are as shown hereon; that the buildings located on said lot do not encroach or project on adjacent streets or property; and that no adjacent walls or buildings encroach or project on this lot; and that there are no utility lines crossing this property except as shown.

FILED
GREENVILLE CO., S.C.
MAY 25 11 52 AM 1957
OLLIE F. JAMES
R.M.C.

[Signature]
Registered Engineer No. 962

12538

MAY 25 1957

PIEDMONT ENGINEERING SERVICE
GREENVILLE S C

77-77

12538 Filed This 25 day of May 1957

and Recorded in Vol. N.N. Page 177 of 177

[Signature]
Register Means Conveyance Greenville County, S.C.