

Plat Book 00, Page 96

REF. PLAT. OF CENTRAL DEVELOPMENT CORPORATION, S. C.
FILED IN PLBK. "BB" PAGE 22+23

FILED


1.00

FEB 22 1958

FEB 22 11 34 AM 1958

4340

OLLIE FARNSWORTH
R. M. C.

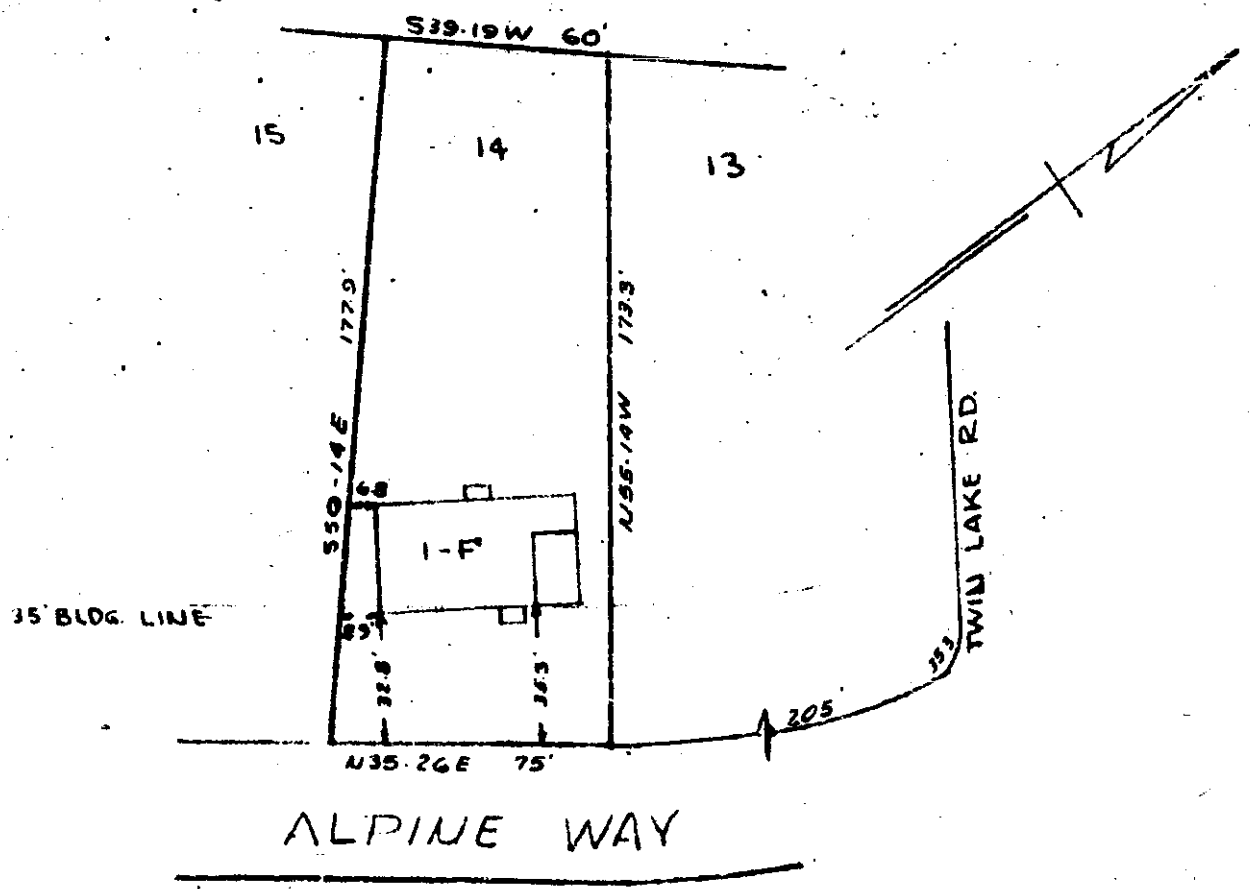

PROPERTY OF
BAXTER T. STEWART
 AND
MARY B. STEWART
 GREENVILLE, S. C.

SCALE 1"=50 FT. 17 JAN 1956

This is to certify that on the 17th day of January, 1956, I surveyed the property shown on this plat; and that the property lines, walls and buildings are as shown hereon; that the buildings located on said lot do not encroach or project on adjacent streets or property; and that no adjacent walls or buildings encroach or project on this lot; and that there are no utility lines crossing this property except as shown.

Recorded February 22, 1958 at 11:34 A. M. #4340

Walter L. ...
 Registered Engineer No. 962



PIEDMONT ENGINEERING SERVICE
 GREENVILLE, S. C.