


BOUND TRACK

TO WASHINGTON

283.4'

①

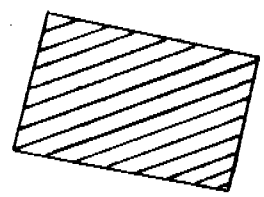

92.4' 116'
I.P. 61.85'

②

S. 89-05 W. 228.9'

N. 89-00 E. 212'

③

S. 89-00 W. 195'

④


N. 14-15 W. 180'
98.7' 61.85'

175'

56.2' I.P. 37.5'

100.2' MAIN STREET
SOUTH 11-43 E. 60'

Total 70.4' 70.4'
N. 7-09 E. 100.2'

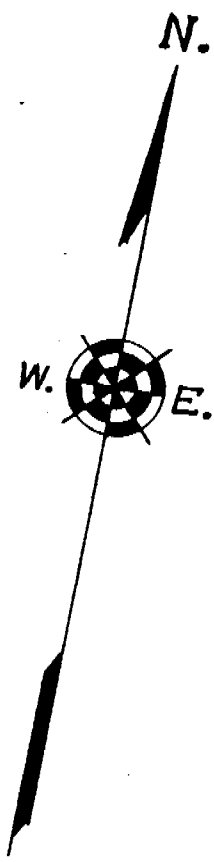

NOTE: PLAT AMENDED
SHOWING LOT NO. 25.
APRIL - 6 - 1959.
H.S.B.

APR 24 1959

