

PROPERTY OF

YOUNTS & SPE

B.F. FLYNN ESTATE

PLAT NO. 1

CHICK SPRINGS TOWNSHIP GREENVILLE CO.

SOUTH CAROLINA

SCALE 1" = 100 FEET. MAY 9 1947


SUB-DIVIDED APRIL 30 1947

H.S. BROCKMAN, SURVEYOR
GREER, S.C.

NOTE

THIS SUBDIVISION CHANGED SLIGHTLY
FROM BROCKMAN SURVEY - PLAT REVISED
AND RE-DRAWN - LOTS RE-NUMBERED
JUNE 25, 1947

BY
H.L. DUNAHOO, SURVEYOR
WINDER, GA.
GA. REG. # 277.

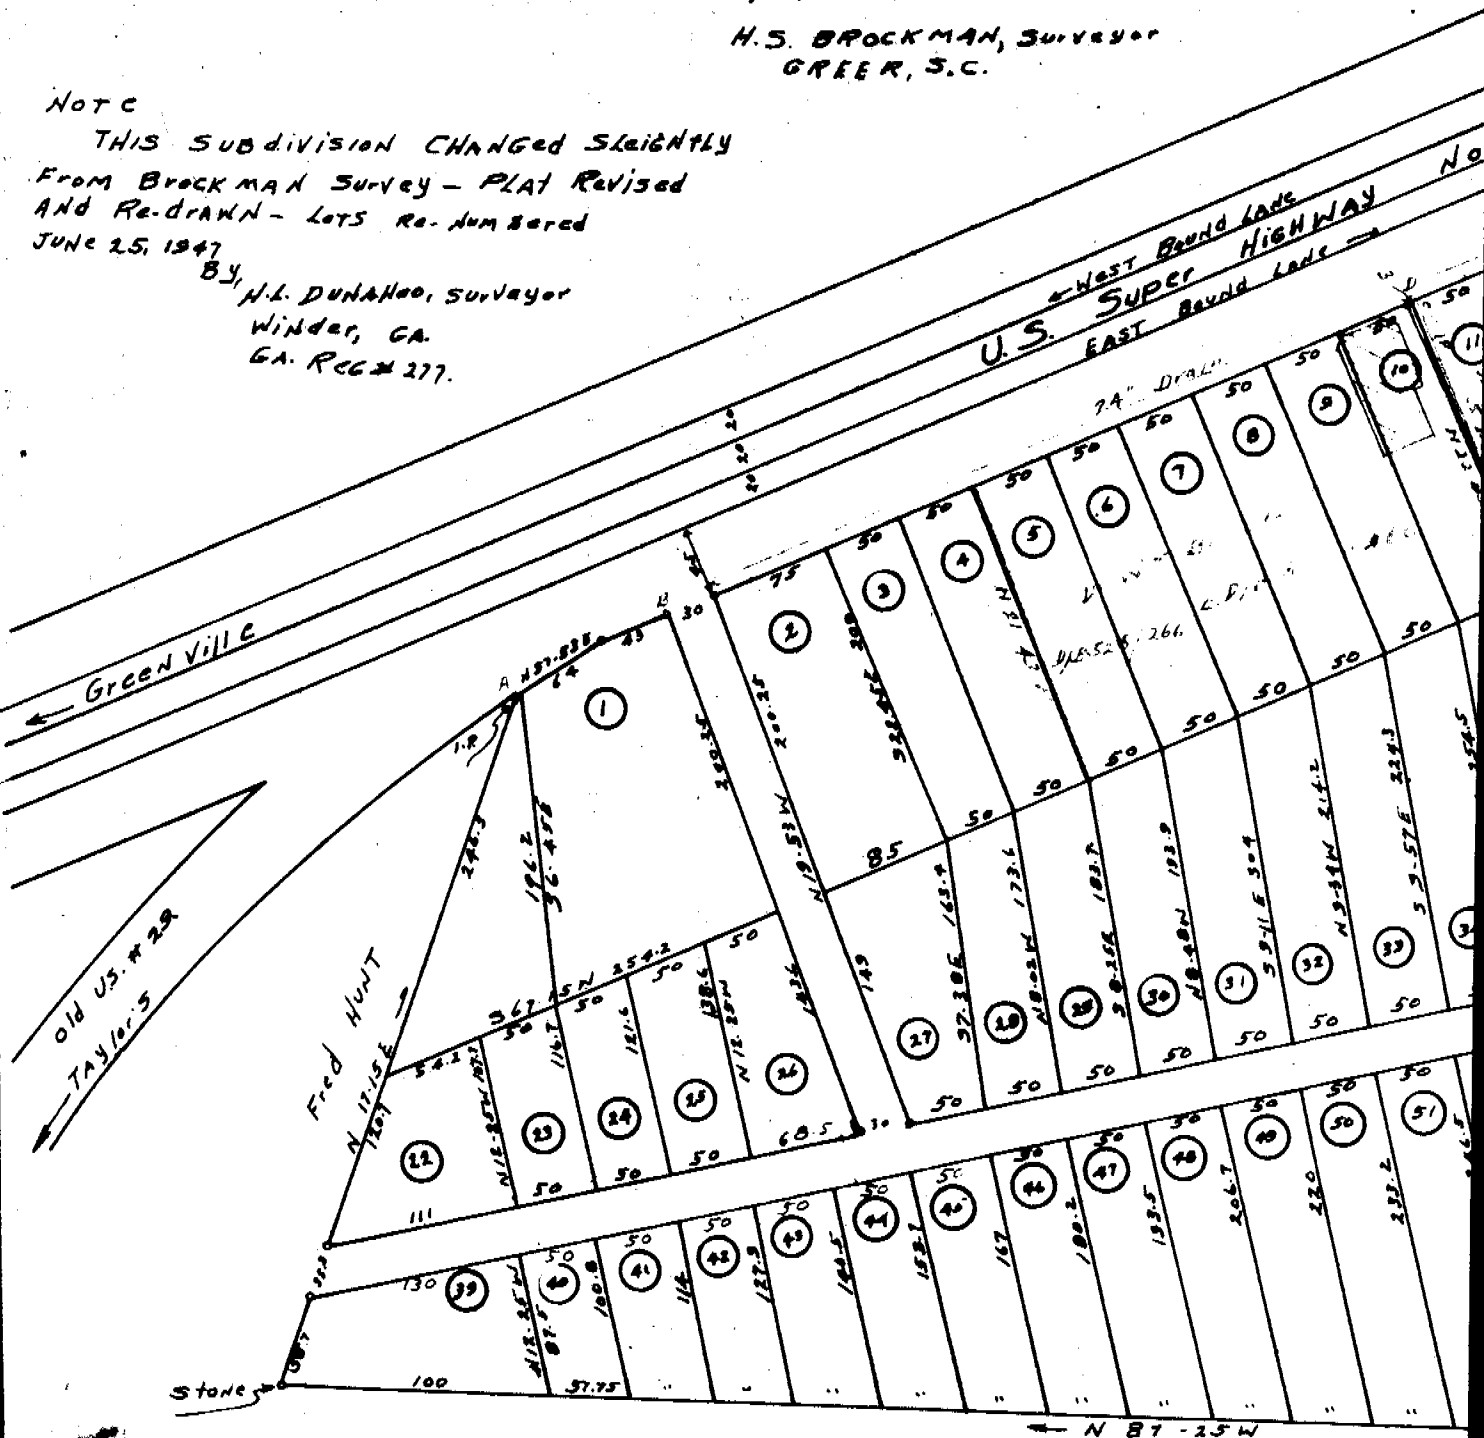

See Report Attached

From Notation on Lots 5 thru 14 Read A 1/4 Sec 14 NW 1/4

G.D. Collier