
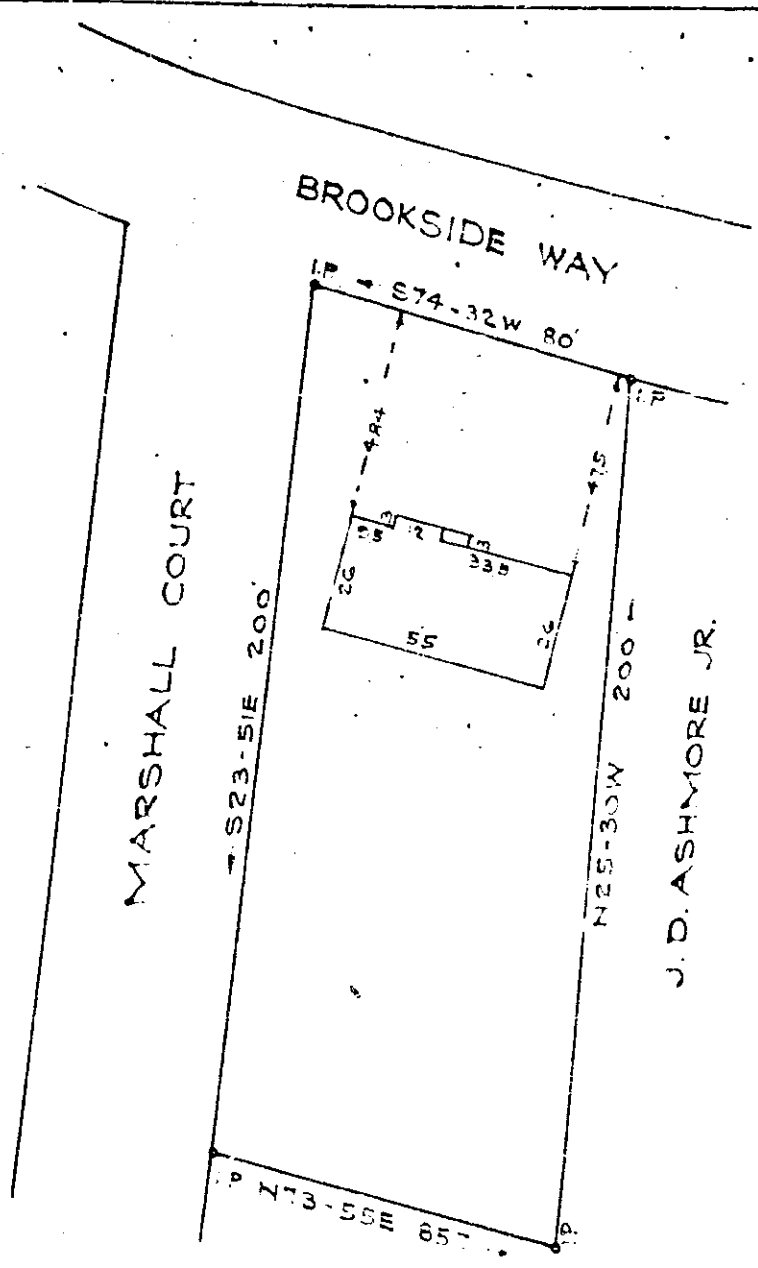


GREENVILLE, CO. S. C.

JUN 20 9 53 AM 1959

Scale 1" = 40'

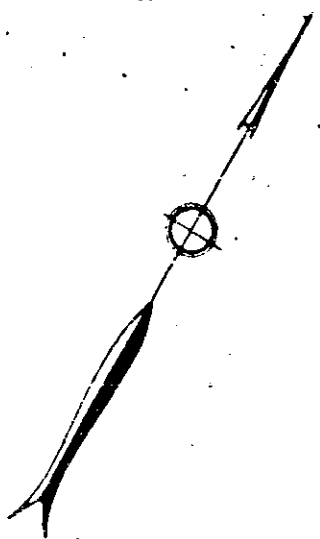

PROPERTY OF  
 JOURDAN J. NEWTON

GREENVILLE S. C.

Scale 1" = 40' June 1959

This is to certify that on the 18th day of June, 1959, I surveyed the property shown on this plat; being shown on Greenville County Block Book on Sheet M 15.2, Block 1, Lot 7; and that the property lines, walls and buildings are as shown hereon; that the buildings located on said lot do not encroach or project on adjacent streets or property; and that no adjacent buildings or walls encroach or project on said premises.

*R. W. Dalton*  
 -----  
 Dalton & Neves, Engineers.

34312

Recorded June 20, 1959 at 9:53 A. M. #34312