Bk. 00 Pg. 525

Application 160625 - Clarence R. Bright

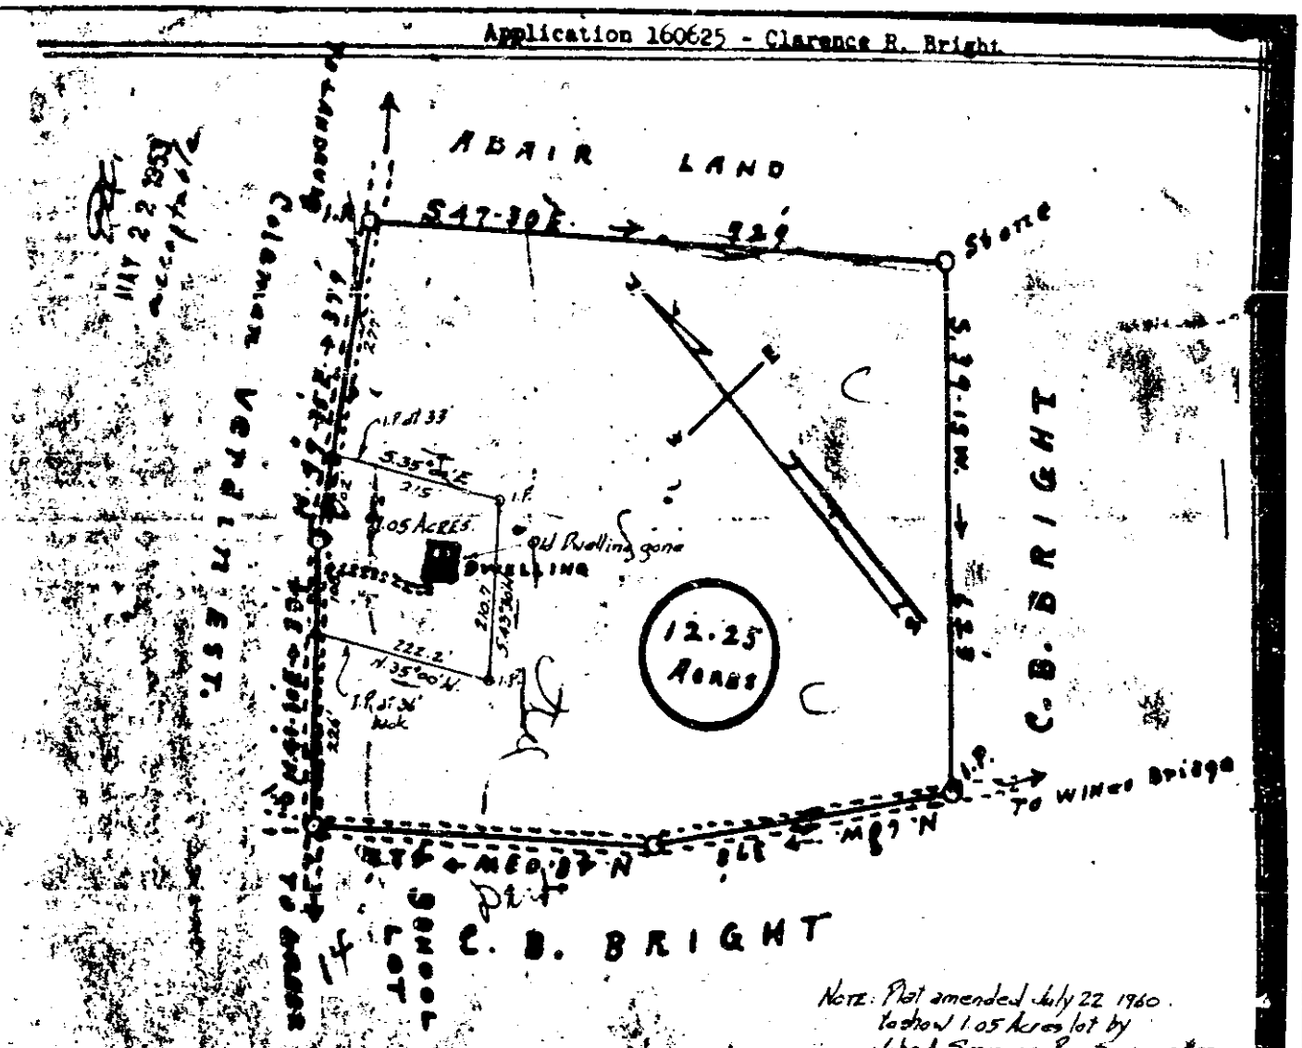

Note: Plat amended July 22 1960. to show 1.05 Acres lot by John A. Simmons, Reg. Surveyor #2212.

PROPERTY OF

C. R. BRIGHT.

LOCATION

10 MILES NORTH OF GREER, S.C.

East side of HIGHWAY No. 114

GREENVILLE COUNTY, S.C.

SURVEYED FEBRUARY 25, 1947.

J.H. ATKINS, SURVEYOR.

CAMPOBELLO, S.C.

Scale:- 1-in = 200 feet

Amended Plat recorded September 2nd, 1960 at 4:15 P.M. # 6421