
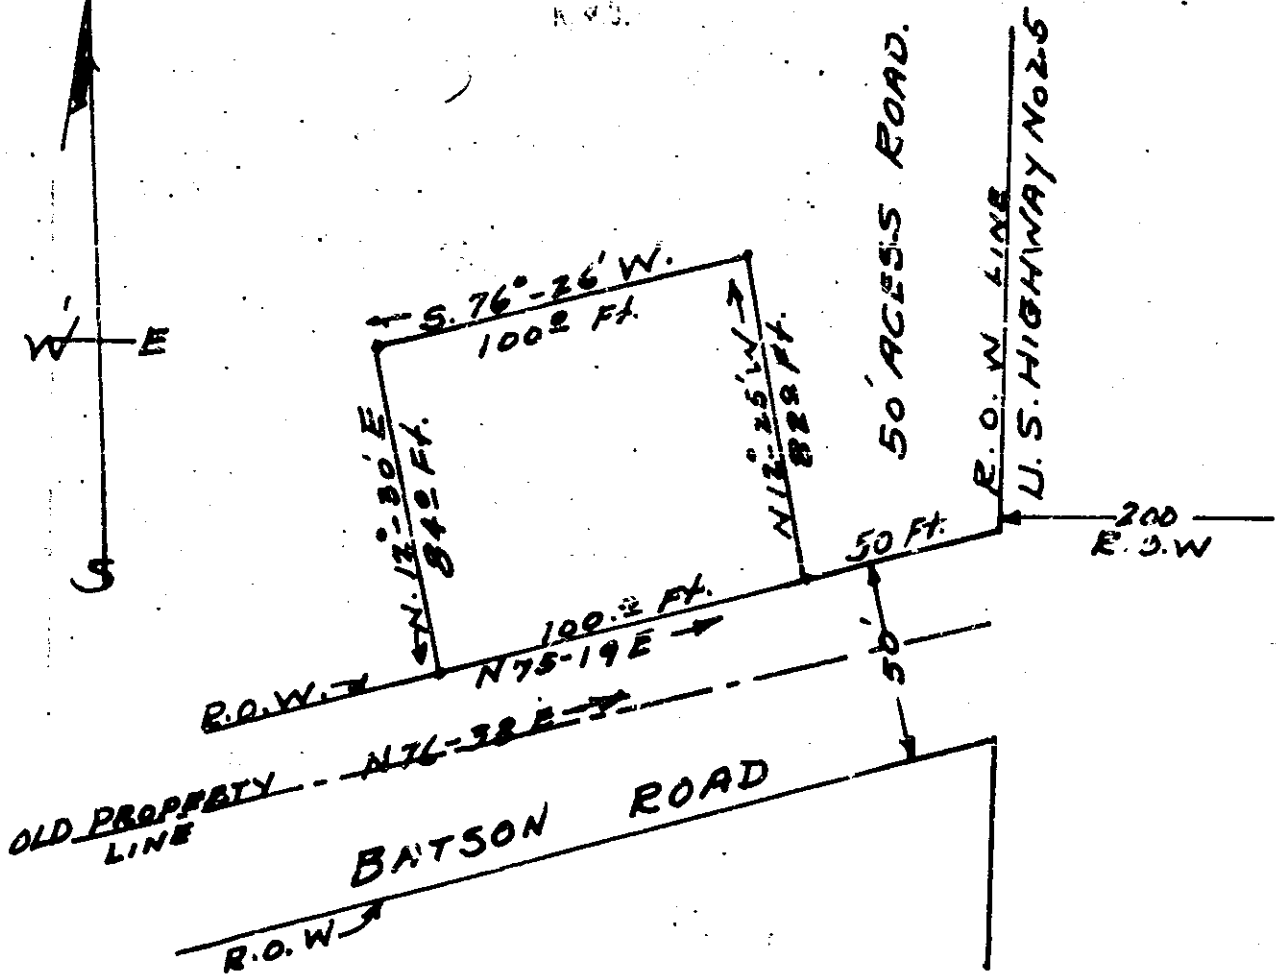


GREENVILLE CO. S. C.

SEP 15 10 03 AM 1960

OLLIE ... BIRTH ...

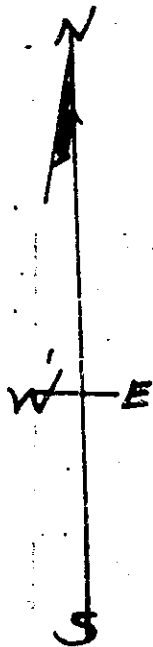

PLAT OF LOT
 ALVIN F. BATSON
 AND
 HOMER STYLES
 TRAVELERS REST,
 DATES TWP. GREENVILLE CO.
 SOUTH CAROLINA.

70152 543

SURVEY BY
 Jimmy J. Dief
 Reg. C. E. & L. S. No 109

Sept. 9, 1960
 Bearings Magnetic
 SCALE 1" = 50'

N.B. BUILDING UNDER CONSTRUCTION

00-533

SEP 15 1960

Recorded September 15, 1960 at 10:03 A. M.