FEB 17 3 28 PM 1958

3907

504

OLLIE [illegible] NORTH
R. M.C.

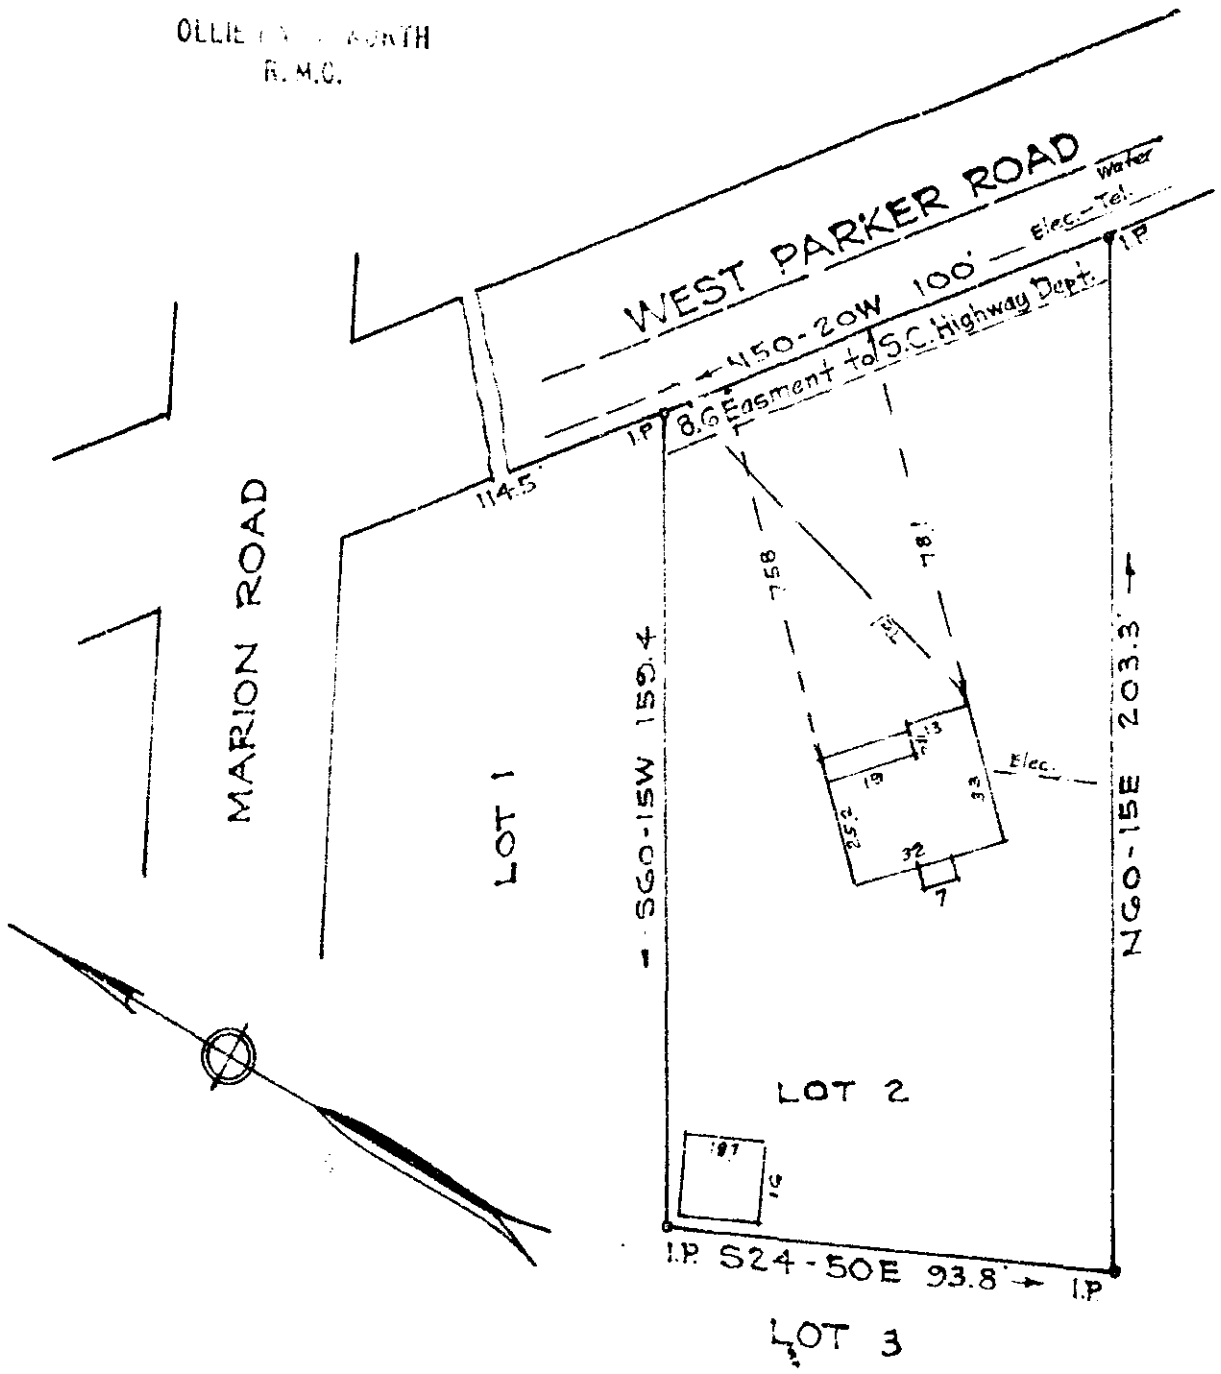

PROPERTY OF
BOBBY J. SEEGER
MOLLY M. SEEGER
NEAR GREENVILLE S.C.
Scale 1"=40' Feb. 1958

This is to certify that on the 14th day of February, 1958, I surveyed the property shown on this plat; being known as Lot 2 on plat of L. F. Nolin; and that the property lines, walls and buildings are as shown hereon; that the buildings located on said lot do not encroach or project on adjacent streets or property; and that no adjacent buildings or walls encroach or project on said premises; and that no utility lines cross this property except as shown hereon.

R. W. Dalton
Registered

Recorded February 17, 1958 at 3:28 P. M. #3907

18 PP-67

3907 17 Feb 58
Recorded PP 67
Gertie Farnsworth
Register Mesne Conveyance Greenville County, S.C.