


FEB 19 11 55 AM 1958

OLLIE F. WORTH  
R.M.S.

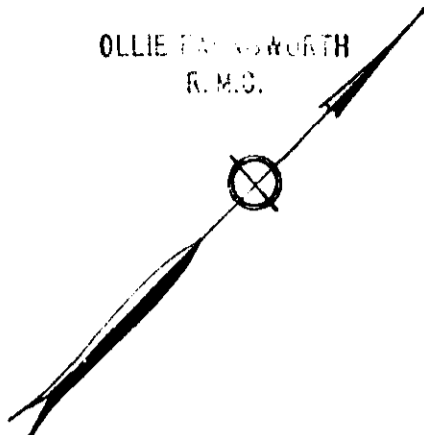

LOT 285 | LOT 284

IP - 543-OW 100' IP

LOT 340

LOT 339

+ S47-OE 224.8

N47-OW 224.8

LOT 341

CHEROKEE DRIVE

285'

IP

N43-OE 100'

IP

CHASTA AVE.

Water  
Elec. Tel.

PROPERTY OF

CHARLES E. PARKS

BETTY JO PARKS

NEAR GREENVILLE S.C.

Scale 1"=50'

Feb. 1958

This is to certify that on the 18th day of February, 1958, I surveyed the property shown on this plat; being known as Lot 340 on plat of Robert J. Edwards; and that the property lines, walls and buildings are as shown hereon; that the buildings located on said lot do not encroach or project on adjacent streets or property; and that no adjacent buildings or walls encroach or project on said premises; and that no utility lines cross this property except as shown hereon.

*R. W. Dalton*

Registered.

PP-75

317

4104 Filed Feb 19 day of Feb 19 58  
And Recorded in Vol. P.P. Page 75 st.

*Ollie F. Worth*  
Register Deeds Conveyance Greenville County, S. C.