


MAR 20 1958

6572

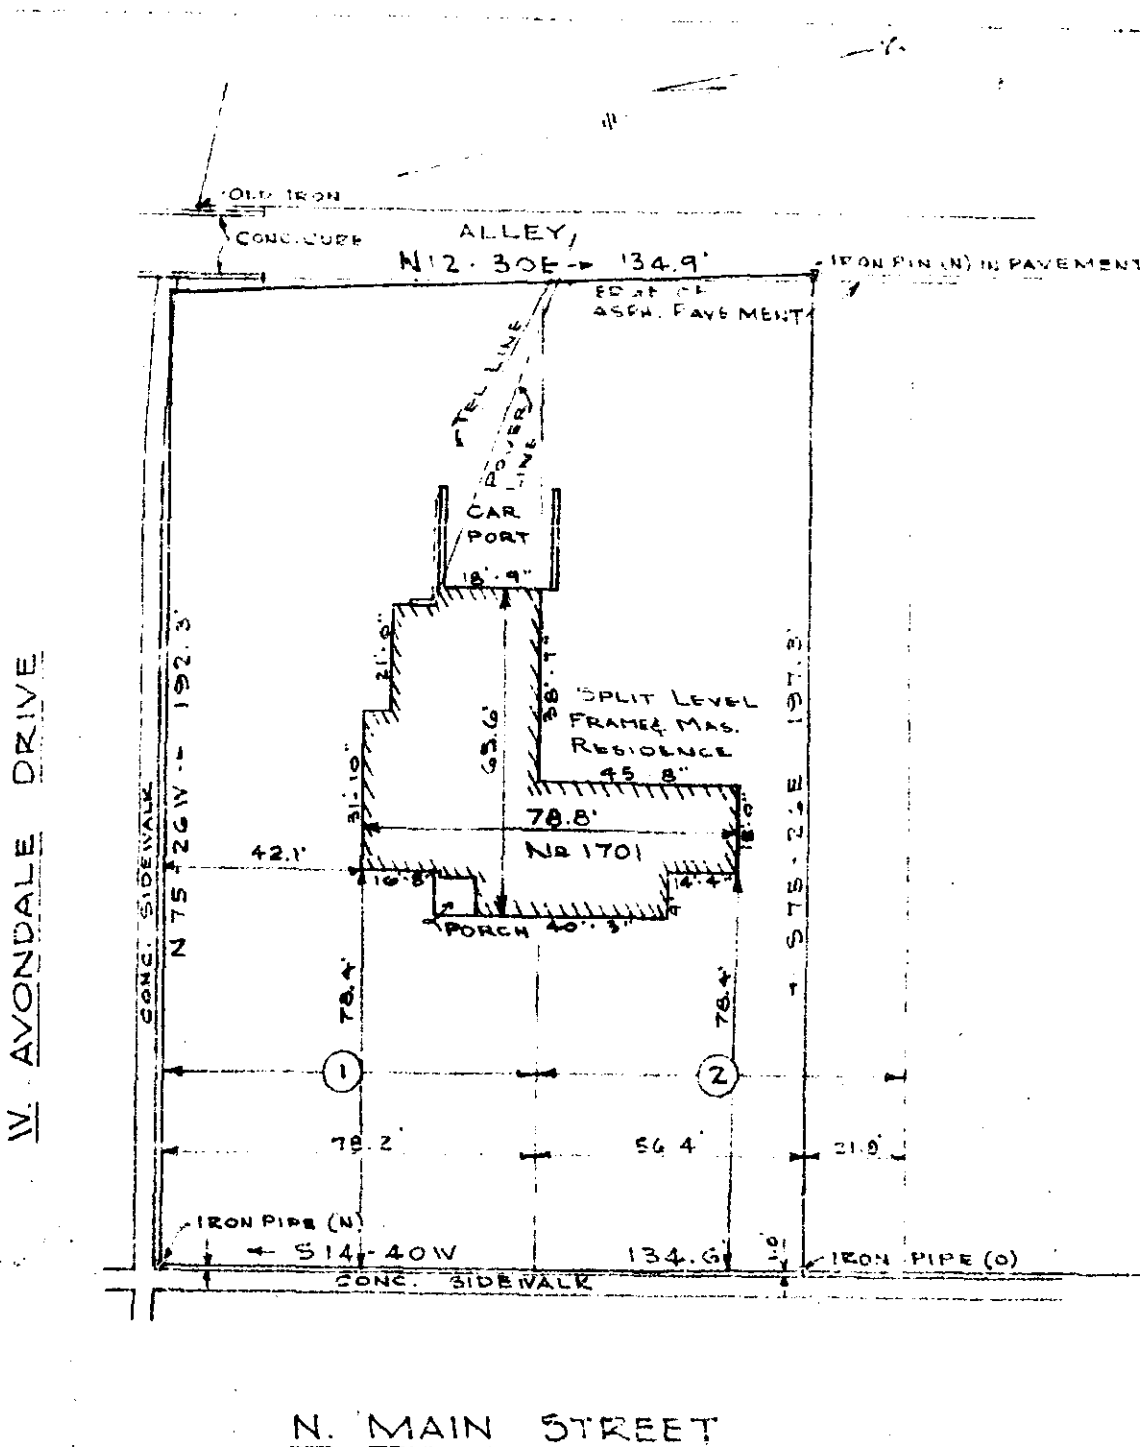

N. MAIN STREET

Plat Showing Property of

CYVIA S. ROSENFELD

Located in "Northgate" in the
CITY OF GREENVILLE, S. C.

Scale: 1" = 40' Dated: March 26, 1956
Revised: March 17, 1958

Pickell & Pickell - Engineers
Greenville, S. C.

I hereby certify that the measurements as shown on this
plat are correct and that there are no projections or encroach-
ments other than shown.

Handwritten signature

R.L.S.

6572 Plat Title 2017 of March 19 1958
 and Recorded in Vol. P.P. Page 91 at
 Register Merne Conveyance Greenville County, S. C.

300 508
98-91