


# Plat Book PP, Page 165 | A

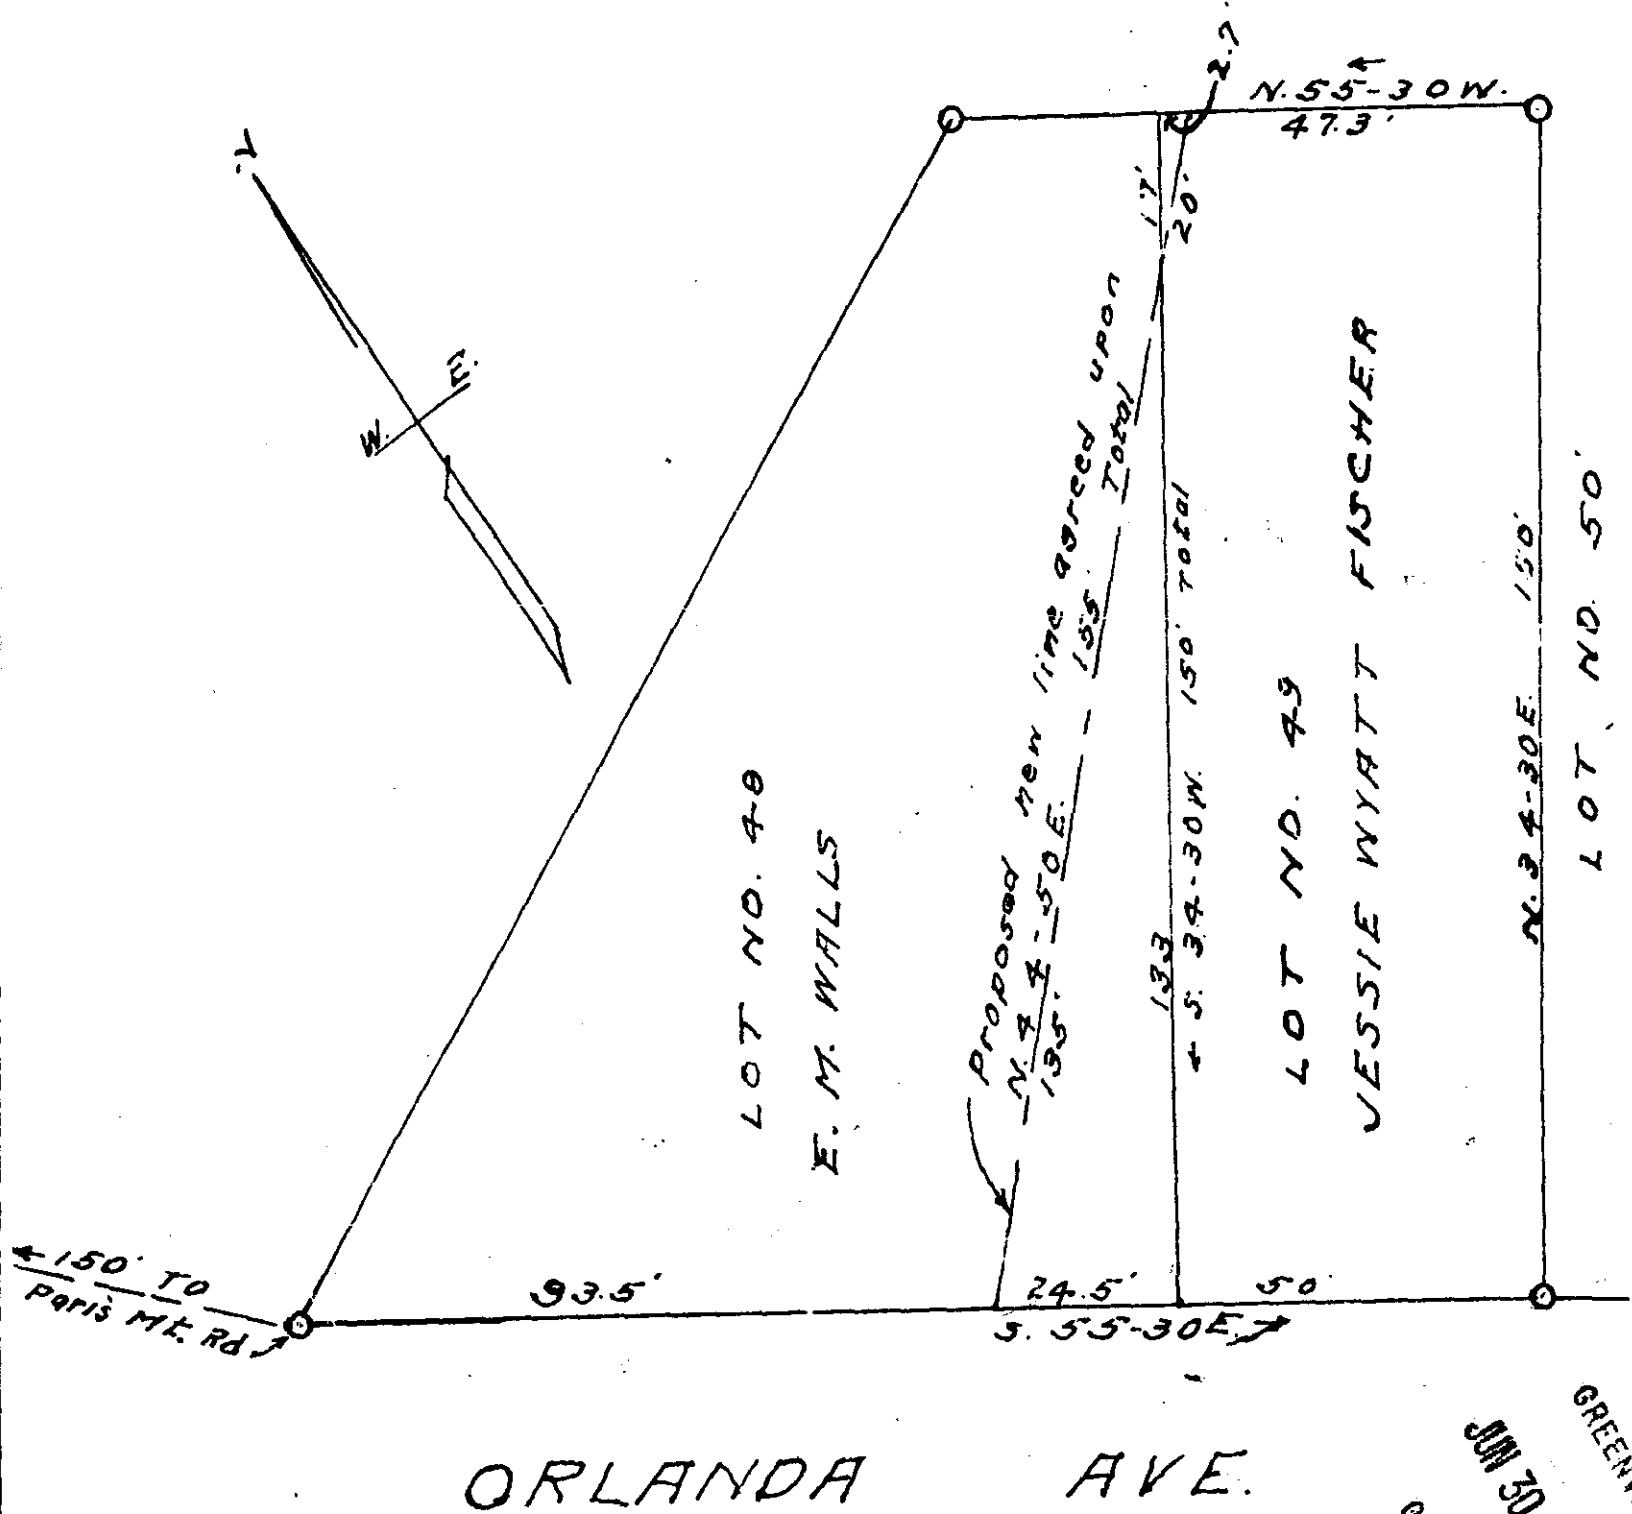

FILED  
 GREENVILLE CO. S. C.  
 JUN 30 12 21 PM 1958  
 OLLIE FARNSWORTH  
 R. M. C.

State of South Carolina,  
 County of Greenville,

333

JUN 30 1958

The above plat represents Lots No's. 48 and 49 of a subdivisi-  
 on known as Paris Piney Park as recorded in office of R. M. C. ~~333~~  
 in plat book H. Pages 19, 20. The two lots are now owned by Mrs.  
 Jessie Wyatt Fischer and E. M. Walls.

Surveyed by W. J. Riddle Mar. 1950; Scale 1 inch = 50 feet.

*W. J. Riddle - Surveyor*

333 Filed This 30 day of June 19 58  
 and Recorded in Vol. P Page 165 at  
 Ollie Farnsworth  
 Register in Charge Greenville County, S. C.