


Plat Book-R-Page 21

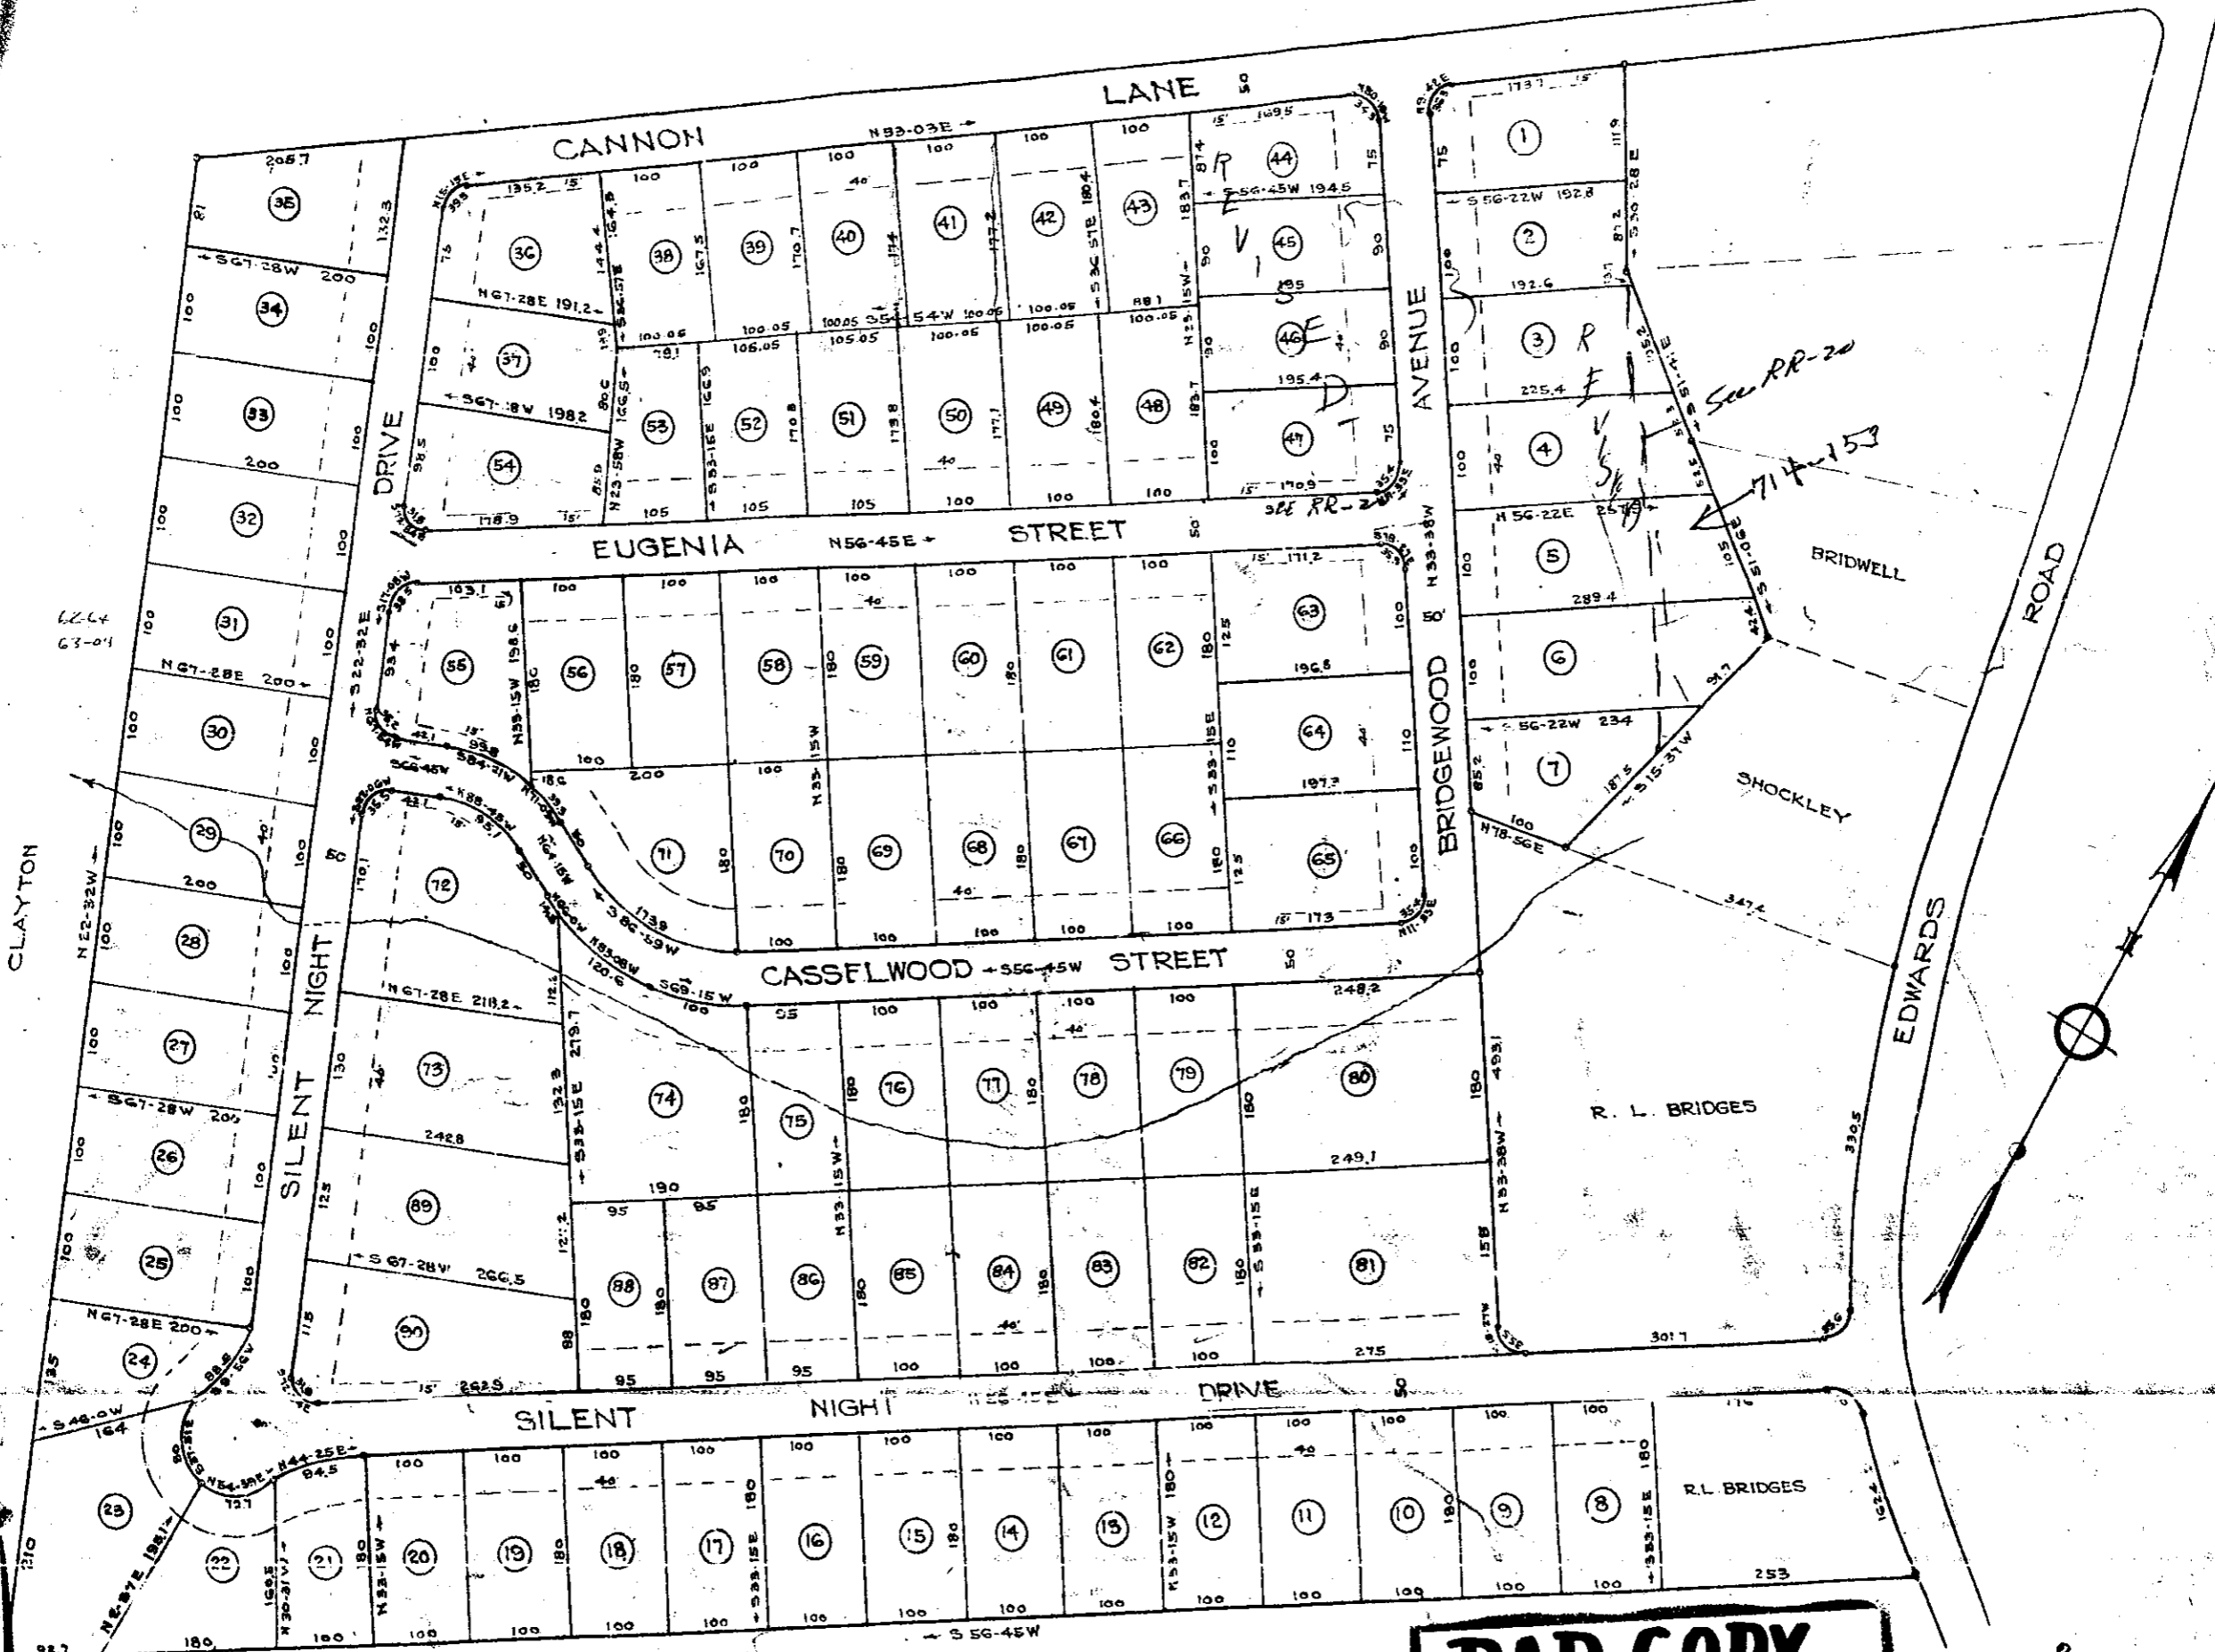

BAD COPY

PROPERTY OF
WILLIAM M. EDWARDS

SECT. NO. 2.
EDWARDS FOREST
NEAR TAYLORS S. C.

SCALE 1"=100' MARCH 1957

DALTON & NEVES

1957 and 13 Aug 1960
and Recorded in P.R.R. Plat Book
R.L. Bridges

NOTE: There is a 10ft. Easement along Creek

Jan 13 1960

RR-21