


Plat Book SS, Page 67 B

19891
JAN 5 1959
GREENVILLE S.C.

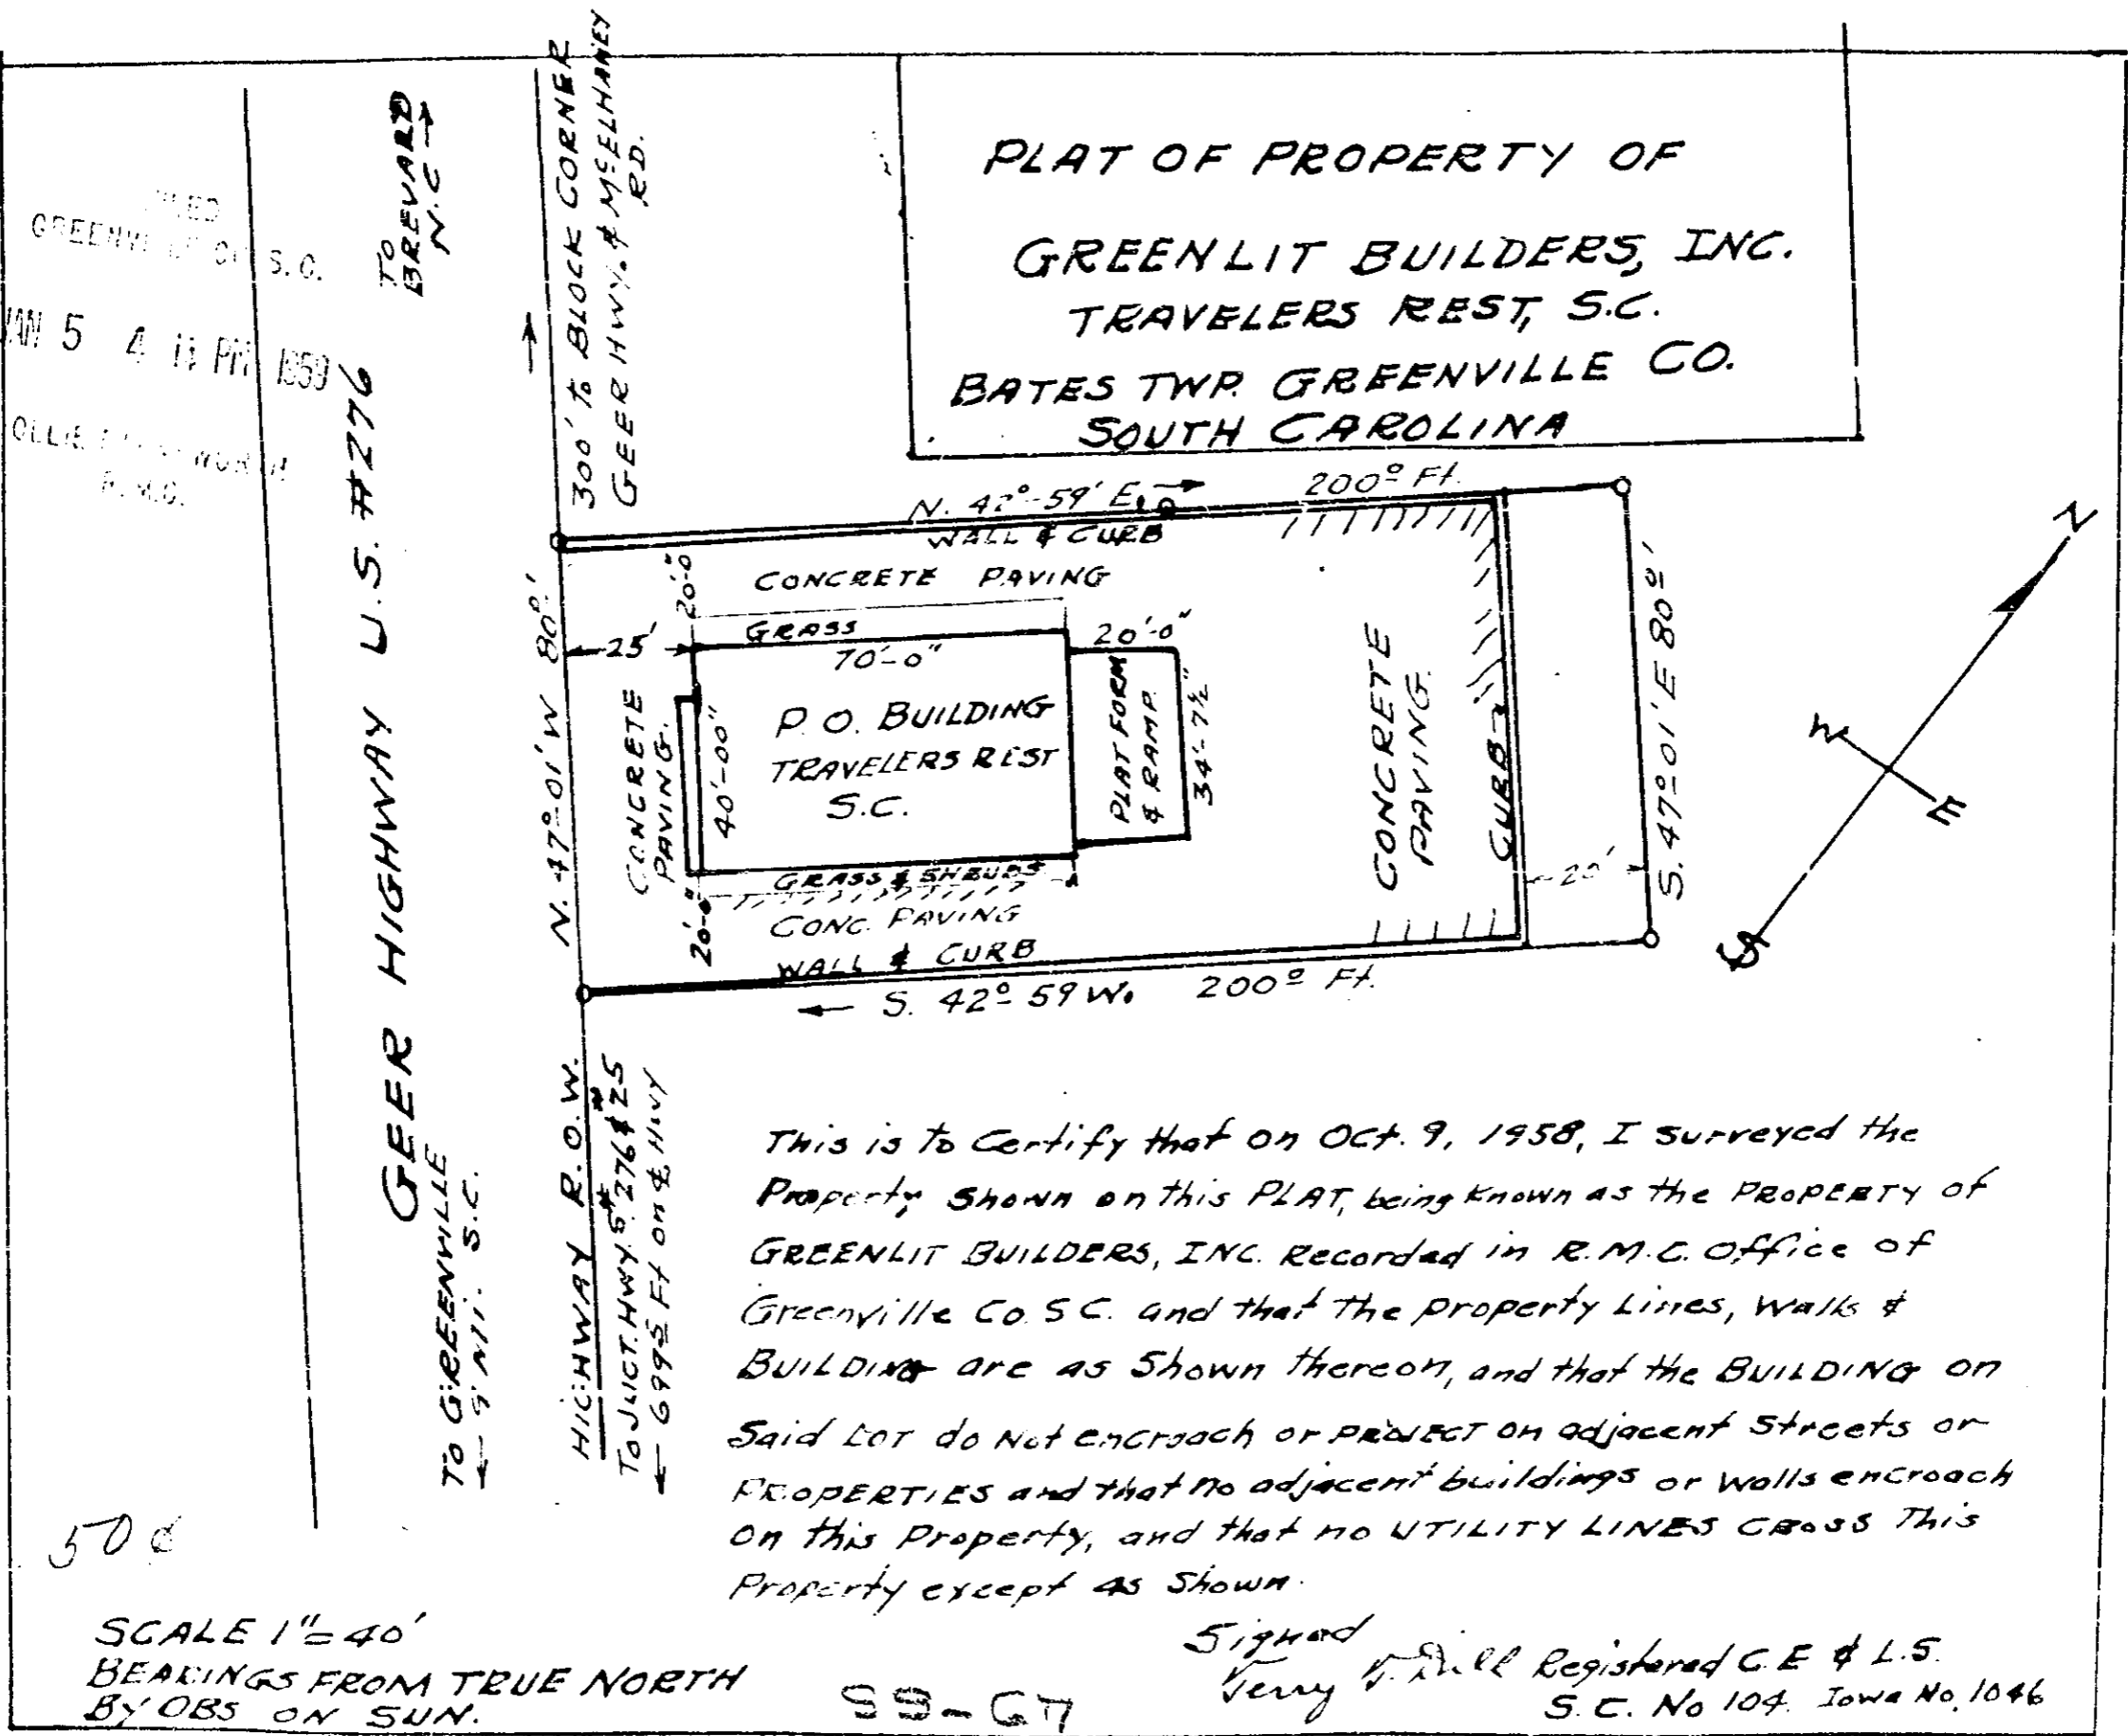

This is to Certify that on Oct. 9, 1958, I surveyed the Property shown on this PLAT, being known as the PROPERTY of GREENLIT BUILDERS, INC. Recorded in R.M.C. Office of Greenville Co. S.C. and that the Property Lines, Walks & BUILDING are as Shown thereon, and that the BUILDING on Said Lot do not ENCRoach or PRoject on adjacent Streets or PROPERTIES and that no adjacent buildings or walls encroach on this Property, and that no UTILITY LINES CROSS This Property except as Shown.

Signed
Vernon H. Hill Registered C.E. & L.S.
S.C. No 104. Iowa No. 1046

